

Section 36 Township 32 Range 43W

Well No. #1 Smith "R"

Company Cities Service

NORTH

			0				

WEST

EAST

SOUTH


SEC.	TWP.	R.
36	32	43W ✓

WELL NO. 1 Smith "R" FARM

COMPANY Cities Service

CONTRACTOR

Greenwood Pool  
 330 Ft. from N. Line  
 Ft. from S. Line  
 330 Ft. from E. Line  
 Ft. from W. Line

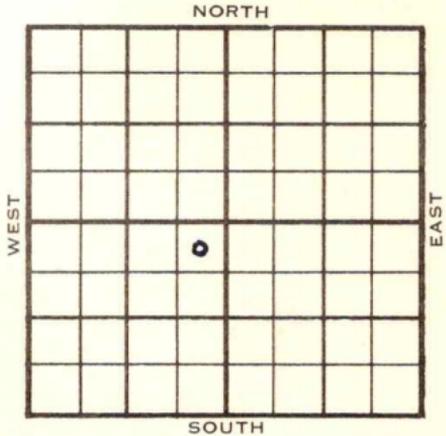

NE NE SW

1954	ELEVATION 3542'	REPORT
------	--------------------	--------

2/24 Location  
 3/3 8" @ 600' w/450 sks  
 3/10 Drlg 3067'  
 3/17 Anhy 1346', Top 2867', Lans 3140'  
 RTD 3310'  
 5" @ 3265'  
 3/24 C.O. Tstg.  
 4/14 Spud 2-24-54  
 Gas Well  
 TD 3310'  
 8" @ 600'  
 Anhy 1346', Top 2867', Lans 3140'  
 TD 3310'  
 5" @ 3265', CO to 3215, 20/3196-3202,  
 70/3176-90, 100/3142-62, 2000A,  
 95,040,000 gas, SP 3100, 100/3010-50,  
 1/2 mcfg, 3000A, 2000A, CO to 3215  
 18,300,00 gas, SP3000, 30/2954-60,  
 30/2942-48, 40/2922-30, 40/2908-16,  
 80/2880-96, 3000A  
 CO to 3215  
 Comp. 21,900,000 cfg

3542  
 2867  
 ---  
 675

**COMPLETED**



