

12-32-5W


WELL LOG BUREAU—KANSAS GEOLOGICAL SOCIETY
508 East Murdock, Wichita, Kansas

Company- JONES-GEBERT OIL CO.
Farm- Humbert No. 1

SEC. 12 T. 32 R. 5W
C SW NW

Total Depth. 4670'
Comm. 1-16-63 Comp. 1-28-63
Shot or Treated.
Contractor.
Issued. 3-30-63

County Harper
KANSAS

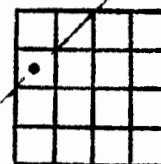

CASING:
8 5/8" 250' cem w/175 sx.

Elevation. 1266' KB

Production. DRY


Figures Indicate Bottom of Formations.

soil & sand	40
red bed	250
red bed & shale	315
shale & lime	350
lime & shale	1375
lime	1490
lime & shale	1690
shale & lime	2918
lime & shale	3125
shale & lime	3209
sand	3325
shale & lime	3465
shale	3530
lime & shale	3615
lime	3808
lime & shale	4170
lime	4254
lime & shale	4275
lime	4380
lime & shale	4425
lime	4513
lime & shale	4554
shale	4645
sand	4670
Total Depth	

TOPS: LOG	
Kansas City	3519
Base Kansas City	3770
Marmaton	3834
Cherokee	4006
Mississippi	4194
Kinderhook	4558
Simpson	4652

12-32-5W

Bessie Humbert & Others
Oil Location

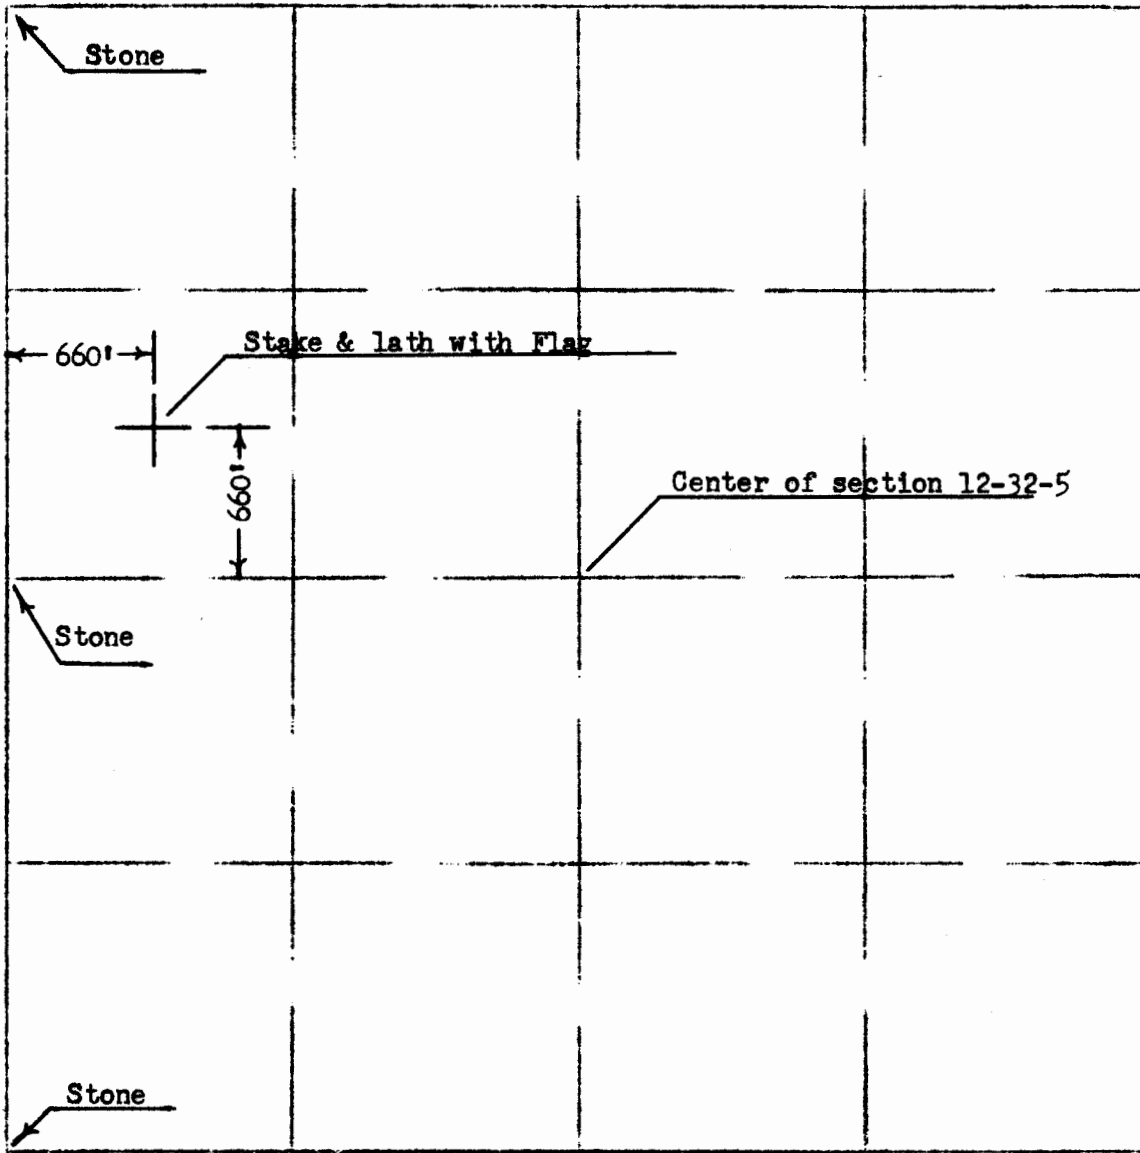

I, Jack C. Scott, of the Office of the County Engineer of Harper County, Kansas, do hereby certify that the center of the $\text{SW}\frac{1}{4}$ of the $\text{NW}\frac{1}{4}$ of Section 12, T32S, R5W of the 6th P.M. is staked as shown and this is a true and accurate accounting of the same.

January 10, 1963

Jack C. Scott
Jack C. Scott