Harper KANSAS

SECTION 18 TOWNSHIP 32 RANGE 5W

WELL NO. #1 Hollman

COMPANY T.L. Ferrier

NORTH SE SE NW

WEST

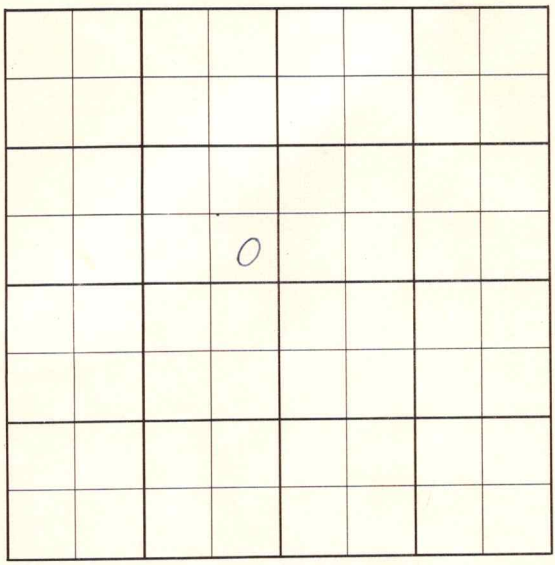

EAST

SOUTH

FORM 504-3 SUNRAY

FORM 513 SUNRAY

County Harper Elev. 1311

Sec. 18 Twp. 32 Rge. 5W

Company T. L. Ferrier

Farm Name Hollman No. 1

TOPS	DEPTH	LOG	DATUM
Anh.			
Tp.			
H.			
Tr.			
Dg.			
Bl.			
L.			
K.C.	3622		
B.K.C.			
Ce.			
C.			
M.	4267		
M.			
K.			
Mz.			
Mo.			
V.			
S.	4696		
S.			
A			
R.			
P€.			
G.			
T.D.	4706		

Loc. in Sec. SE SE NW

Geol.

Contr. Gravley Tools

Pool Wildcat

ABANDONED

O

MAY 1 '57

Date Comm. 4-8-57 Tex. DHM

8" @ 263/225, WOC APR 17 '57 Ø 3525

APR 24 '57 DST 4270-80 op 1 hr. rec 20' Md BHP 40 Ø 4430

MAY 1 '57 DST 4696-4704 thru rec 2700' SW BHP 1895/15"

DEA

Co. Lse. No. Sec. T. R.

WILDCAT

FORM 513 SUNRAY

County Harper Elev.

Sec. 18 Twp. 32 Rge. 5W

Company T. L. Ferrier

Farm Name Hollman No. 1

TOPS	DEPTH	LOG	DATUM
Anh.			
Tp.			
H.			
Tr.			
Dg.			
Bl.			
L.			
K.C.			
B.K.C.			
Ce.			
C.			
M.			
M.			
K.			
Mz.			
Mq.			
V.			
S.			
S.			
A			
R.			
P€.			
G.			
T.D.			

Loc. in Sec. SE SE NW

Geol.

Contr. Gravey Tools

Pool Wildcat

FIRST REPORT

APR 10 57

Date Comm. 4-8-57

8" @ 263/225, WOC

28

Co. Lse. No. Sec. T. R.