

Well No. 1 Burke Farm

~~K. L. C. 1977-80~~ Company

~~Bar~~ Bu-ii-Bar

WEST

SOUTH

EAST

Drilling Remarks

Drilling Remarks

Cased_____in. _____ft.

Sand

Gas

Oil _____

Total Depth _____

1st 24 hrs. Nat. _____

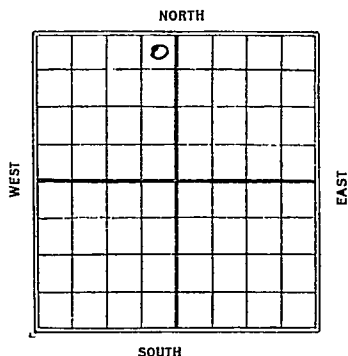
1st 24 hrs. after shot _____

Gas_____cu. ft.

Dry Hole

Abandoned _____

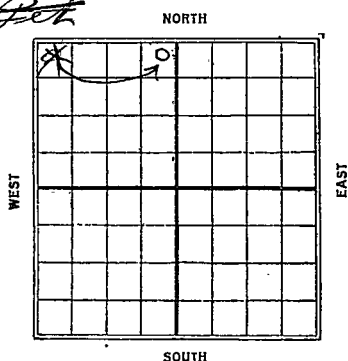
330 Ft. from W. Line

[illegible]

Map No. Kansas Sec. 19 Twp. 32 R. 5 ^WWell No. 1 ~~Bayer~~ Burke Farm
~~Hal C. Moore~~ Bu-Vi-Bar
~~Berry Pet~~ Company330 Ft. from N. Line

Ft. from S. Line

Ft. from E. Line

330 Ft. from W. LineDate 1925 REPORT9/2 Location10/6 2465011/4 S.D. @ 1230'11/11 —————19264/14 S.D. Still have a
fishing job.4/21 —————4/29 —————5/5 Fishing pipe5/12 Drilling by pipe
T.D. 1905'5/26 Drlg by pipe & tools6/2 " 2260 Set 10" C. 19576/9 Drlg 2480'6/16 T.D. 2540 S.D. for finances6/23 —————6/30 S.D.7/14 same7/22 —————8/11 Drlg 2865-H.F.W.

8/18 - T.D. 3010 - 8" - collapsed
 400' off bottom.

8/25 - T.D. 3035 - U.R. 8"

9/1 - Drlg 3140

9/8 - " 3275

9/15 - " 3315

9/22 - no report

9/29 - T.D. 3508 fishing
 tools

10/6 - S.D. High water

10/13 - Drlg 3610

10/20 - " 3670

10/27 - " 3690

11/3 - " 3695

11/10 - " 3790

11/17 - " 3900

11/24 - " 3910

12/1 - T.D. 4000' - S.D.

12/8 - Same

12/15 —

12/21 —

12/29 —

1927

1/5 —

1/12 —

1/19 —

1/26 —

2/2 - T.D. 4000 - starting up

2/9 - Cleaning out 4000 T.D.

2/16 —

2/23 - Drlg 4026 in shale

3/2 - " 4070

3/9 —

3/16 - " 4090

3/23 - " 4170

3/30 - Drlg 4265 - fighting cave

4/6 - Drlg 4300

4/13 - Run 4 7/8" liner at 4300

No Map
 Map No. **KANSAS** Sec. 19 Twp. 32 R. 511

Well No. #1

H. C. Moore Company

Contractor

SECTION PLAT

330 Ft. from N. Line

_____ Ft. from S. Line

_____ Ft. from E. Line

330 Ft. from W. Line

0			

FIRST REPORT

Location _____

Rig up _____

Drilling and Remarks:

Loc.

RECORD

Cased _____ in., _____ ft.

Sand _____

Gas _____

Oil _____

Total Depth _____

PRODUCTION

1st 24 hrs. Nat. _____

1st 24 hrs. after shot _____

Gas _____ Cu. Ft.

Dry Hole _____

Abandoned _____

Date

SEP 2 1925

S. J. LEWIS

Scout

Map No. KANSAS Sec. 19 Twp. 32 R. 5NWell No. 1 BayusBerry P & T. Company

Contractor

SECTION PLAT

230 Ft. from N. Line

_____ Ft. from S. Line

_____ Ft. from E. Line

230 Ft. from W. Line

0			

Correction.

Location _____

Rig up _____

Drilling and Remarks:

*This has
changed hands
and the
Berry P & T. has
it now - was
Hood.*

RECORD

Cased _____ in., _____ ft.

Sand _____

Gas _____

Oil _____

Total Depth _____

PRODUCTION

1st 24 hrs. Nat. _____

1st 24 hrs. after shot _____

Gas _____ Cu. Ft.

Dry Hole _____

Abandoned _____

Date

SEP 30 1925

192

S. J. LEWIS

Scout

Map No. KANSAS Sec. 19 Twp. 32 R. 511

Well No. #1 Burke

Berry P & T Company

Contractor

SECTION PLAT

330 Ft. from N. Line

_____ Ft. from S. Line

330 Ft. from E. Line

_____ Ft. from W. Line

Correction

Location _____

Rig up _____

Drilling and Remarks:

Loc was
W. W. and
should be
NE. W.

RECORD

Cased _____ in., _____ ft.

Sand _____

Gas _____

Oil _____

Total Depth _____

PRODUCTION

1st 24 hrs. Nat. _____

1st 24 hrs. after shot _____

Gas _____ Cu. Ft.

Dry Hole _____

Abandoned _____

Date ..

OCT 6 1925

S. J. LEWIS Scout

Map No. **KANSAS** Sec. 19 Twp. 32 R. 5W

Well No. 1 Burke

Bu-Vi-Bar Company

Contractor

SECTION PLAT

	0		

330 Ft. from N. Line

_____ Ft. from S. Line

330 Ft. from E. Line

_____ Ft. from W. Line

Correction

Location _____

Rig up _____

Drilling and Remarks:

Bu-Vi-Bar
has taken
this over from
the Berry Ed.

RECORD

Cased _____ in., _____ ft.

Sand _____

Gas _____

Oil _____

Total Depth _____

PRODUCTION

1st 24 hrs. Nat. _____

1st 24 hrs. after shot _____

Gas _____ Cu. Ft.

Dry Hole _____

Abandoned _____

Date

MAR 9 1927

S. J. LEWIS Scout

Map No. KANSAS Sec. 19 Twp. 32 R. 5NWell No. 1 BurkeBu-Vi-Bar Company

Contractor

SECTION PLAT

230 Ft. from N. Line

Ft. from S. Line

230 Ft. from E. Line

Ft. from W. Line

	0		

ABANDONED

Location

Rig up

Drilling and Remarks:

TII 4425DYA

RECORD

Cased _____ in., _____ ft.

Sand _____

Gas _____

Oil _____

Total Depth _____

PRODUCTION

1st 24 hrs. Nat. _____

1st 24 hrs. after shot _____

Gas _____ Cu. Ft.

Dry Hole _____

Abandoned _____

Date

MAY 18 1927

S. J. LEWIS

Scout

Harper

MAP NO. 141534 SEC. 19 TWP. 37S R. 5WWELL NO. 1 BurkeBerry & Bu On Bar COMPANY

CONTRACTOR

SECTION PLAT

	0		

____ Ft. FROM N. LINE

____ Ft. FROM S. LINE

____ Ft. FROM E. LINE

____ Ft. FROM W. LINE

OK. check
into well

LOCATION _____

RIG UP _____

DRILLING AND REMARKS:

line at
4425

RECORD

CASED _____ IN. _____ FT.

SAND _____

GAS _____

OIL _____

TOTAL DEPTH 4425

PRODUCTION

1ST 24 HRS. NAT. _____

1ST 24 HRS. AFTER SHOT _____

GAS _____ CU. FT.

DRY HOLE _____

ABANDONED _____

DATE

5/17 1927

SCOUT