


Section 19 Township 32 Range 5 W

Well No. # 1 Daniels

Company T. E. Adkins et al

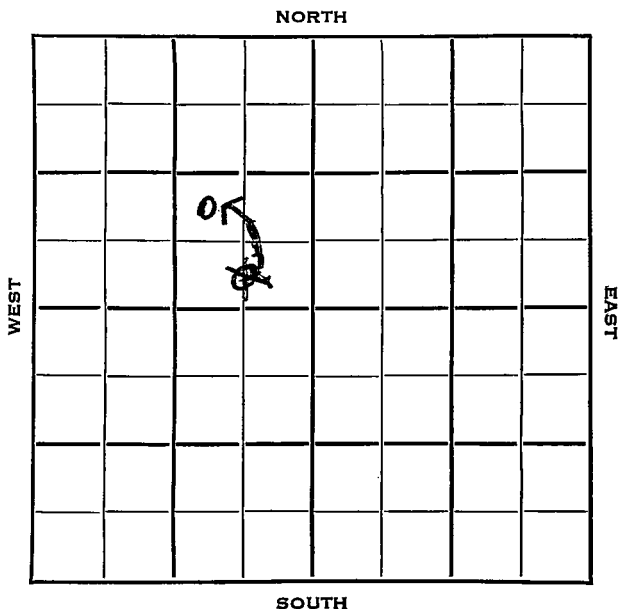

KANSAS ✓

Harper

32

5W

19

Sec. _____ Twp. _____ R. _____

#1 Daniels

Well No. _____ Farm _____

T. E. Adkins et al

Company _____

Catline & Dodson

Contractor _____

Ft. from N. Line


~~990~~~~330~~

Ft. from S. Line

~~990~~~~660~~

Ft. from E. Line

Ft. from W. Line

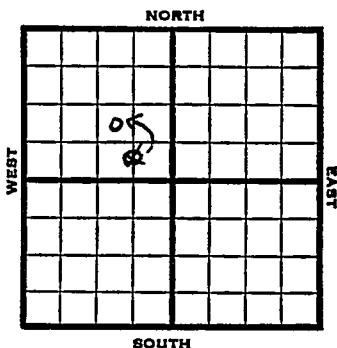~~NW SE NW~~~~C SE SE NW~~

1952 Elev. 1334' REPORT


12/3 Spud 11-22-52
 10" @ 162
 Drlg. 3100'

12/11 Lans 3695 Miss 4325 DST 4326-37
 1/2 Hr. 20' M. Ø

12/17 Spud 11-22-52
 D&A
 TD 4407'
 10" @ 162
 Lans 3695, Miss 4325,
 DST 4326-37, opn 1/2 hrs., rec.
 20' mud, 102#
 TD 4407
 Miss 4388
 D&A

ABANDONED

County Harper State Kansas
 Sec. 19 (Blk.) 32 (Sur.) 5W Map No. _____
 Operator T. E. Adkins et al.
 Well No. 1 Farm Daniels
 Elev. 1334 Location NW SE NW

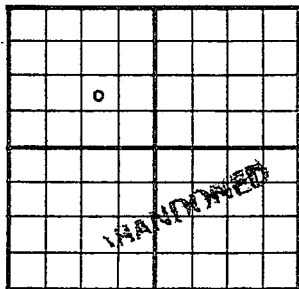

990 Ft. From S Line NW
990 Ft. From E Line Quarter

1st. Report

Completion DEC 17 1952

Remarks

Catline & Dodson - Contr

Spudding Date 11-22-52

Drlg. Data D & A TD 4407

10" @ 162 Lans. 3695 Miss. 4325


DST 4326-37 open $\frac{1}{2}$ hr. Rec. 20' mud

102# TD 4407 Miss. 4388

D & A

J. G. McGEHEE

County Harper State Kansas
 Sec. 19 (Blk. 32 (Sur. 5W Map No.
 (Twp.) (Rge.)
 Operator T. E. Adkins et al.
 Well No. 1 Farm Daniels
 Elev. Location C SL SE NW

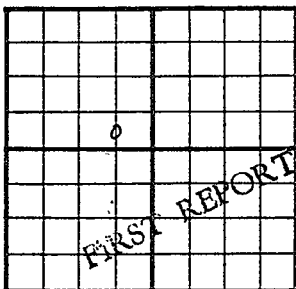

330 Ft. From S Line NW
660 Ft. From E Line Quarter

1st. Report DEC 3 1952

Completion _____

Remarks _____

Catline & Dodson - Contr.

Spudding Date 11-22-52

Drlg. Data.

10" @ 162 drlg. 3100

J. G. MCGEHEE

Map No. _____ Sec. 19 Twp. 32 R. 5W

Well No. 1 Daniels

Adkins et al. Company

CORRECTION Contractor

NW SE NW


SECTION PLAT

_____ Ft. from N. Line

990 Ft. from S. Line

990 Ft. from E. Line

_____ Ft. from W. Line

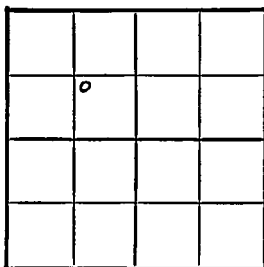

Harper County

Location _____

Rig up _____

Drilling and Remarks:

Reported

C. S. L. SE NW

RECORD

Cased _____ in., _____ ft.

Sand _____

Gas _____

Oil _____

Total Depth _____

PRODUCTION

1st 24 hrs. Nat. _____

1st 24 hrs. after shot _____

Gas _____ Cu. Ft.

Dry Hole _____

Abandoned _____

Date

DEC 3 1952 19

J. G. McGEHEE

Scout