


Section 24 Township 32 Range 5 WWell No. # 1 SchoenCompany Rine Drlg.

NORTH

WEST

EAST

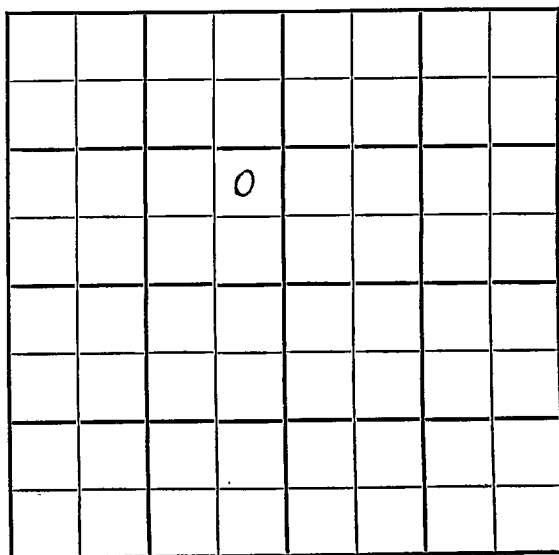

SOUTH

SEC.	24	TWP.	32	R.	5W
------	----	------	----	----	----

WELL NO. #1 Schoen FARM

COMPANY Rine Drlg.


CONTRACTOR Patton

_____ Ft. from N. Line

990 _____ Ft. from S. Line

330 _____ Ft. from E. Line


_____ Ft. from W. Line

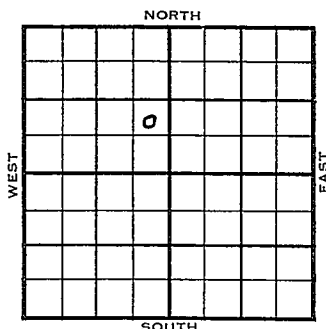

NE SENW

	ELEVATION	REPORT
1954	1262'	
11/23	Spud 11-22-54 8-5/8" @ 292'	
12/15	Spud 11-22-54 D & A TD 4945 8-5/8" @ 292 Tarkio 2190 Howard 2426', Severy 2476 DST 2500-45 open 1 hr rec 190' SGCM 1117# Top 2582 DST 2774-2827 open 1 hr rec 5' mud 916# Heeb 2949 Tor. 2969 KC 3568 Miss. 4269 Simp. 4723 DST 4723-35 open 1 hr rec 210' GCMW 720' SGCM 1751# Arb. 4884 TD 4945 D & A	

ABANDONED

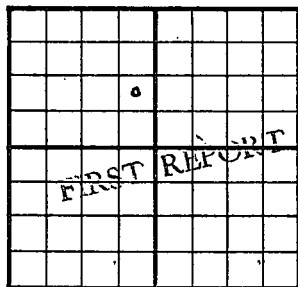County Harper State KansasSec. 24 (Blk.) 32 (Sur.) 5W Map No.Operator Rine Drlg.Well No. 1 Farm SchoenElev. Location NE SE NW990 Ft. From S Line NW330 Ft. From E Line Quarter1st. Report NOV 22 1954

Completion


Remarks

Patton - Contr.Spudding Date 11-22-54

Drlg. Data

8 5/8" @ 292

FABEN GILSTRAP

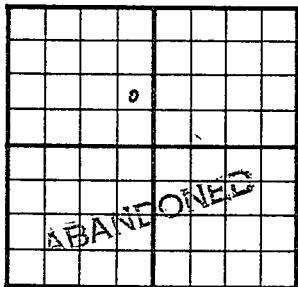County Harper State KansasSec. 24 (Blk. Twp.) 32 (Sur. Rge.) 5W Map No.Operator Rine Drlg.Well No. 1 Farm SchoenElev. 1262 Location NE SE NW990 Ft. From S Line NW330 Ft. From E Line Quarter

1st. Report

Completion DEC 15 1954

Remarks

Patton - Contr.Spudding Date 11-22-54Drlg. Data D & A TD 49458 5/8" @ 292 Tarkio 2190 Howard 2426Severy 2476 DST 2500-45 open 1 hr.Rec. 190' sgcm 1117# Top. 2582DST 2774-2827 open 1 hr. Rec. 5' mud916# Heeb. 2949 Tor. 2969 KC 3568Miss. 4269 Simp. 4723 DST 4723-35open 1 hr. Rec. 210' gcmw 720' sgcmw1751# Arb. 4884 TD 4945D & A

FABEN GILSTRAP