

Harpur
 Map No. KANSAS Sec. 19 Twp. 32 R. 6 ^W
 Well No. 1- Thompson Farm
J.B. Stick et al Company

NORTH

WEST

EAST

0							

SOUTH

Location.....

Drilling Remarks

.....

.....

RECORD

Cased..... in..... ft.
 Sand.....
 Gas.....
 Oil.....
 Total Depth.....

Rig Up.....

Drilling Remarks

.....

.....

PRODUCTION

1st 24 hrs. Nat.....
 1st 24 hrs. after shot.....
 Gas..... cu. ft.
 Dry Hole.....
 Abandoned.....


Map No. KANSAS Sec. 19 Twp. 32 R. 6^W
 Well No. 5 Thompson Farm
J. B. Slick et al company

330 Ft. from N. Line

_____ Ft. from S. Line

_____ Ft. from E. Line

330 Ft. from W. Line

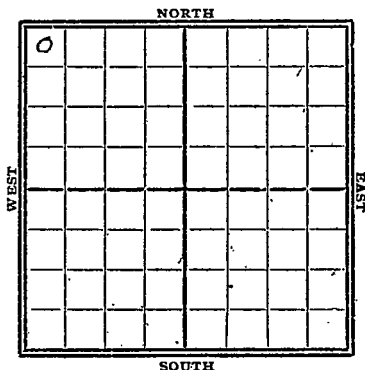

1929

Date	REPORT
6/19	Pool
6/26	Rig
7/2	
7/10	Drill 2410'
7/17	" 2445'
7/24	" 3700'
7/31	" 4100'
8/7	" 4388'
8/14	8"-4606 Rust
8-21	—
8/28	No report
9/4	Drill 4810'
9/11	" 4815 B.T. 4870'
9/18	" 4949'
9/25	T.D. 4950' 4000' water show of oil - Will Run 6" Monday - S.D.
9/28	
10/2	—
10/9	—
10/16	Set cement - water broke in - Re-cem

10/23- T.D. 4950'

Drilled out cement
Water broke in
Re-Cementing

10/30- Top Wilcox 4967
Dry 4978' HFW

11/6- " 5035'

11/13- " 5100'

11/20- S.D. 5125

11/27- T.D. 5125'

Dry & Abandoned

Map No. KANSAS Sec. 19 Twp. 82 R. 6 W

Well No. 1 Thompson

H. B. Slick & Co. Company

Contractor

SECTION PLAT

330 Ft. from N. Line

11 1/2 Ft. from S. Line

 Ft. from E. Line

330 Ft. from W. Line

0			

FIRST REPORTS

Location.....

Rig up.....

Drilling and Remarks:

RCG

RECORD

Cased.....in.,ft.

Sand.....

Gas.....

Oil.....

Total Depth.....

PRODUCTION

1st 24 hrs. Nat.....

1st 24 hrs. after shot.....

Gas.....Cu. Ft.

Dry Hole.....

Abandoned.....

Date

JUN 19 1929

S. J. LEWIS Scout

*Harper*Map No. *32* KANSAS Sec. *19* Twp. *32* R. *6 W*Well No. *1 Thompson**T. B. Slick & Son* Company

Contractor

SECTION PLAT

330 Ft. from N. Line

Ft. from S. Line

Ft. from E. Line

330 Ft. from W. Line

<i>0</i>			

ABANDONED

Location

Rig up

Drilling and Remarks:

RECORD

Cased *2* in., *5* ft.

Sand

Gas

Oil

Total Depth *5125*

PRODUCTION

1st 24 hrs. Nat.

1st 24 hrs. after shot

Gas Cu. Ft.

Dry Hole

Abandoned

Date

*NOV 27 1929**S. J. LEWIS* Scout