

Harper


KANSAS

SECTION 11 TOWNSHIP 32S RANGE 7W

WELL NO. #1 Coryell

COMPANY Walters Drlg.

NORTH SE SE SE

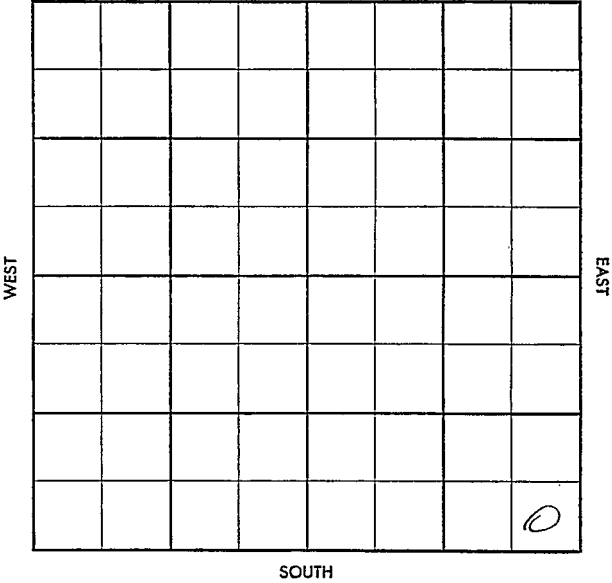

Twp. X Pool X
 Co. X Facet X

S-513.B

County Harper Elev. 1426 KB/1457
 Sec. 11 Twp. 32 Rge. 7W
 Company Walters Drig.
 Farm Name Corvell No. 1

TOPS	DEPTH	LOG	DATUM
Amh <u>Elgin</u>	<u>3065</u>		
Tp.			
H.			
Tr.			
Dg.			
B.L.			
L.			
K.C.	<u>3774</u>		
B.K.C.	<u>4002</u>		
Ce.			
C.			
M.	<u>4353</u>		<u>-2927</u>
M.			
K.			
Mz.			
Mq.			
V.	<u>4711</u>		
S.	<u>4714</u>		
S.			
A.			
R.			
Pf.			
G.			
T.D.	<u>4767</u>		

Loc. in Sec. SE SE SE
 Geol. _____
 Contr. _____
 Co. Tools _____
 Pool Harper
Wildcat DISC

COMPLETE
 MAY 28 '58

Date Comm. 4/7/58 (Skelly-DHM)

8" @ 215' W/165' WOOD APR 15 '58 3282
 APR 23 '58 DST 4355-79 3282 DST
 (SP) 3470-3515 up 58" see 330
 M SW FP 35-210 BHP 1465-1330
 DST 4355-79 g/l 1/2 see DST 4360-79
 3 1/2 hrs g/l 1/2 ga 5.300 imp 5"
 5.900 imp 3 1/2 hrs see 6 dist
 FR 725-700 BHP 1765-1730/60"
 APR 30 '58

Co. 1
 Sec. 11
 Twp. 32
 Rge. 7W
 No. 1

DST 4379-4410 1 1/2 hrs.
 350' ot gem 350' gemsw spot oil
 300' gem 300' sw 7P 90 550
 BHP 1915-62/20 t 4710-15
 rec. 1' sh 3' dol w/550 1' sd w/50
 DST 4707-15 2 hrs. gas 1 1/2"
 3500 mefg 45" 6' dist
 BHP 1825 7P 365-45
 t 4715-22 7' sd
 DST 4715-22/30" gas 1" 6000 mefg
 1/4" 3' dist 7P 750-995
 BHP 1830-40 t 4722-32 10' sd
 DST 4722-32 1/2 hr. gas 1"
 7120 mefg 1' dist 7P 840-1010
 BHP 1840- t 4732-42 rec.
 10' sd DST 4733-42 gas 4"
 500 mefg stab c 850 mefg
 600' free tail gr. 46° 333' hr
 7P 4500-500 BHP 1840-
 t 4742-66 23' netty sd
 run log MAY 7 '58 5" 4767/1250.
~~run log~~ MAY 14 '58 4/4732-33
 BM ga 734 met (H) ga 11,000
 met 1/4 hr MAY 21 '58 ga 7,000 met
 + 41.6 BO NW 13 hrs 3 1/4" ckt 51
 gr 40° MAY 23 '58 c so c cap Flc 15,000 met
 SIP 1546 + 25BO 4 1/2 hrs
 gas well
 SIMP sd

11-32-7W

se se se

~~Pool~~ ~~Pool~~
~~Pool~~ ~~Pool~~ ~~2X~~
WILDCAT

S-513-B

County Harper Elev. _____
 Sec. 11 Twp. 32 Rge. 7W
 Company Walters Drig.
 Farm Name Coryell No. 1

TOPS	DEPTH	LOG	DATUM
Anh.			
Tp.			
H.			
Tr.			
Dg.			
B.L.			
L.			
K.C.			
B.K.C.			
Ce.			
C.			
M.			
M.			
K.			
Mz.			
Mq.			
V.			
S.			
S.			
A.			
R.			
Pf.			
G.			
T.D.			

Loc. in Sec. SE SE SE
 Geol. K
 Contr. _____
 Co. Tools _____
 Pool Wildcat

FIRST REPORT
 APR 9 1958

Date Comm. 4/7/58 (Skelly-DHM)
8" @ 215 w/165 WOC

Co.
Lse.
No.
Sec.
T.
R.