


Section 14 Township 32 Range 7 W

Well No. # 1 Bebmeyer

Company Musgrove Pet.

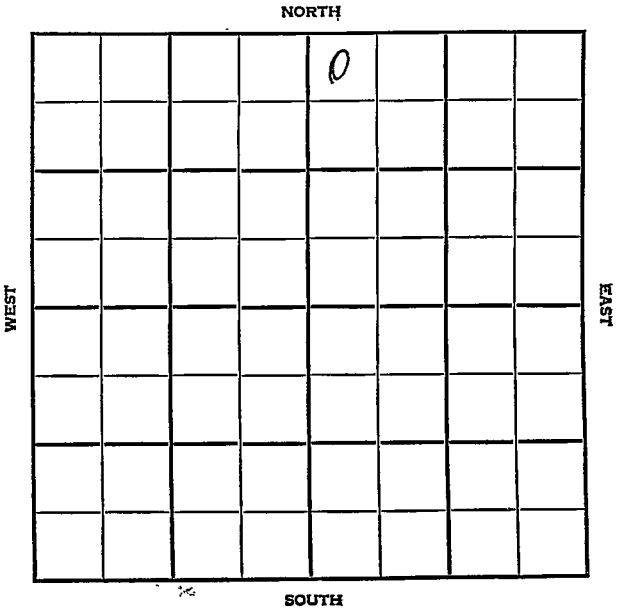

SEC.	14	TWP.	32	R.	7W
------	----	------	----	----	----

WELL NO.

#1 Bebmeyer

FARM

COMPANY

Musgrove Pet.

CONTRACTOR

Co. Tools.

Wildcat.

330

Ft. from N. Line


Ft. from S. Line

Ft. from E. Line

330

Ft. from W. Line

NW NW NE

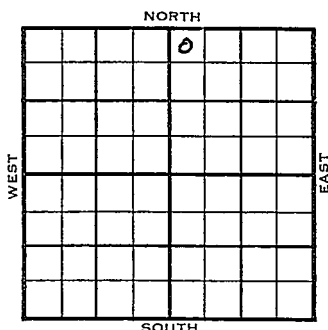

1954

ELEVATION

1418'

REPORT

11/23

Spud 11-21-54
Setting Surface.

12/15

Spud 11-21-54 D & A TD 4900
 8" @218 Oread 3184 Heeb 3203
 Doug. 3355 Lans 3600 Stal. 3606
 KC 3783
 DST 3790-3825 open 1 hr rec 275' SW
 1435# Miss 4359 Kh. 4606 Simp. 4726
 DST 4720-32 open 1 hr rec 1360' mud
 1800' SW 1920# Arb. 3884 TD 4900
 D & A

ABANDONED

FABEN GILSTRAP

County Harper State Kansas

Sec. 14 (Blk. Twp.) 32 (Sur. Rge.) 7W Map No.

Operator Musgrove Pet.

Well No. 1 Farm Bebmeyer

Elev.	1418	Location	NW NW NE
-------	------	----------	----------

330 Ft. From N Line NE

330 Ft. From W Line Quarter

1st. Report

Completion DFC 1 5 1954

Remarks Wildcat

Co. tools

Spudding Date 11-21-54

Drig. Data D & A TD 4900

8" @ 218 Oread 3184 Heeb. 3203

Doug. 3355 Lans. 3600 Stal. 3606

KC 3783 DST 3790-3825 open 1 hr.

Rec. 275' sw 1435# Miss. 4359

Kh. 4606 Simp. 4726 DST 4720-32

open 1 hr. Rec. 1360' mud 1800' sw

1920# Arb. 3884 TD 4900

D & A

FABEN GILSTRAP