


Section 17 Township 32S Range 7W

Well No. #1 Garber.

Company Aurora Gasoline

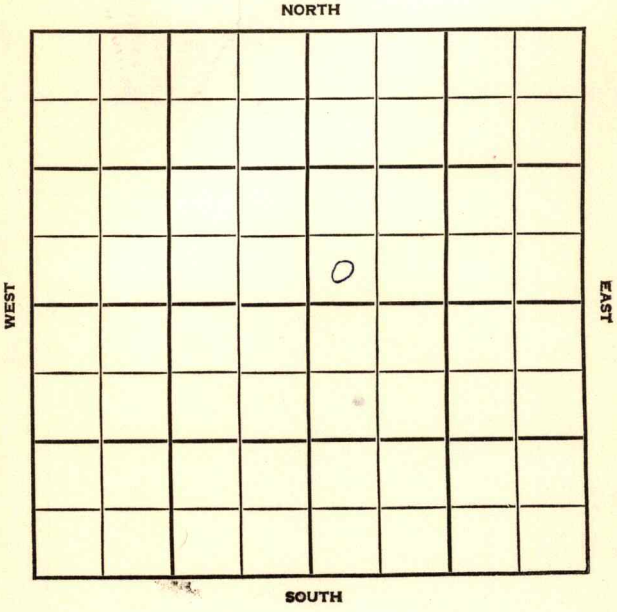

Harper

KANSAS


SEC.	TWP.	R.
17	32S	7W

WELL NO.

1 Garber FARM
COMPANY

Aurora Gasoline
CONTRACTOR

_____ FT. FROM N. LINE
_____ FT. FROM S. LINE
_____ FT. FROM E. LINE
_____ FT. FROM W. LINE

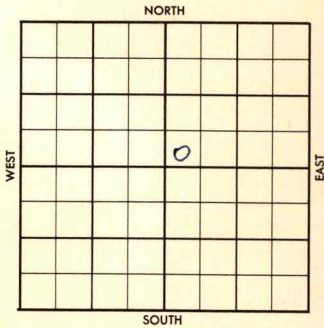

SW SW NE

	ELEVATION	REPORT
1956	1415'	
6-20		Comm. -- to go by 6-25-56 4950' test
6-28		Loc
7-5		Loc
7-12		"
7-19		"
7-26		Spud 7-20-56 8 5/8" @ 204 w/200 Drlg. 1754
8-2		Heeb. 3273, Oread 3391'; KC 3850'; Drlg. 4017';
8-9		Ce. 4293'; DST 4403-15, op 1 hr, rec. 7' mud, 50/30" Miss. 4401'; DST 4417-38, op 1 1/2 hr., gas in 13 min, rec. 60' g&ocm, 60' gassy muddy oil, 750' g&swco, 270' wtr., 135/20". DST 4411-28' op 1 hr., rec. 15' mud, 40/20". DST 4720-34' op 1 hr., 15 min, gas in 21 min, rec. 85' hmco, 1170/37", Viola 4712'; DST 4735-45, op 1/2 hr., rec. 5' mud, 0#. Drlg. 4769'

1956

8-15 DST 4764-90 op 90 min. rec. 3030'
gssy SW, BHP 1860/20".

D & A

S. Dolo 4771'; S. sd. 4788'; A. 4926';

Log tops:

H. 3274'; M. 4404'; V. 4725'; ##

S. Dolo 4754'; S. Sd. 4793'; A. 4913';

TD 4976'

ABANDONED

County Harper Elev. 1475
 Sec. 17 Twp. 32S Rge. 7W
 Company Aurora Gasoline
 Farm Name Garber No. 1

	DEPTH	LOG	DATUM	Loc. in Sec.
				SW SW NE
H.	3273	3274		
Tr.	<u>orlad</u> 3391			
Dg.				
Bl.				
L.				
K.C.	3850			Geol.
B.K.C.				Contr.
Ce.	4293			
C.				
M.	4401	4404		Pool
M.				
K.				
Mz.				
Me				
V.	4712	4725		
S.	<u>0010</u> 4721	4754		ABANDONED
S.	<u>8d</u> 4788	4793		
A.	4926	4913		
R.				
PE.				
G.				
TD.	4976			

ABANDONED
 0
 51 AUG 15 '56

Date Comm. to go by 6-25-56 - 4950' Test

JUN 27 '56 SOHIO F.O. Phillips DHM

JUL 3 '56 ✓ JUL 11 '56 JUL 18 '56 JUL 25 '56

7-20-56 8 5/8 204/200

1754 AUG 1 '56 174017

AUG 8 '56 DST 4403-15 1hr. run

7' Md BHP ⁵⁸208/130" DST 4417

-38 90" 9/13" run 60' GE'OCM

+60' gssy Md y oil +750' G-E SWC

(50% oil) +270' wtr BHP 1350/20

DST 4411-28 1hr rec.
15' Md BHP 50/40 40/20"

DST 4720-34 op 1hr & 15"
rec 9/21" rec 85' HMCO

FP 40-40 1170/37" DST
4735-45 30" rec 5' Md

BHP 0 ϕ 4769

AUG 15 '58

DST ~~4764-9~~ 4764-90
90" rec 3030' 9554 SW
BHP 1860/20"

D&A

County Harper Elev. _____
 Sec. 17 Twp. 32S Rgs. 7W
 Company Aurora Gasoline
 Farm Name Garber No. 1

TOPS	DEPTH	LOG	DATUM	Loc. in Sec.
Anh.				SW SW NE
TP.				
H.				
Tr.				
Dg.				
Bl.				
L.				Geol. _____
K.C.				Contr. _____
B.K.C.				
Ce.				
C.				
M.				Pool _____
M.				
K.				
Mz.				
Mo.				
V.				
S.				
S.				
A.				
R.				
PE.				
G.				
T.D.				

FIRST REPORT
 JUN 20 1956

Date Comm. to go by 6-25-56 - 4950' Test

JUN 25 1956

27

Co. L. Sec. No. Sec. T. R.