

KANAS

Harper

Section 21 Township 32 Range 7W

Well No. 1 Dent

Company Gulf

Wildcat

NORTH

WEST

EAST

							0

SOUTH

Harper

KANSAS

Sec. 21 Twp. 32 R. 7W

Well No. #1 Dent Farm _____
Gulf _____ Company _____

Wildcat


330' Ft. from N. Line

_____ Ft. from S. Line

330' Ft. from E. Line

_____ Ft. from W. Line

NE/C

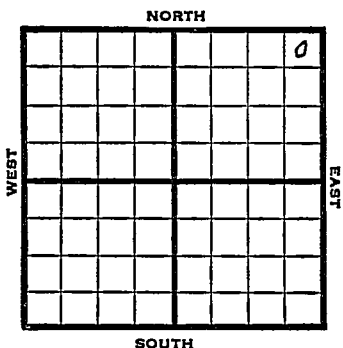

1949

Elev 1403' REPORT

6/15

Location

6/21

"

6/28

Surface Hole

7/6

13" @ 1210'

Drlg 1500'

7/12

Drlg. 3510'

7/20

Dogglass 3584'

KC 3855'

Fsg 4272'

7/27

Miss 4409'

Simp 4772'

Arb. 4916'

Drlg 4941'

9/3

TD 5050'

Arb. 4916'

Aband.

3855
1403
2452

ABANDONED

Harper County Kansas State

Map No. _____ Sec. 21 Twp. 32 R. 7W

Well No. 1 Dent

Gulf Company

Contractor

NE/C

FIRST REPORT SECTION PLAT

330 Ft. from N. Line

_____ Ft. from S. Line

330 Ft. from E. Line

_____ Ft. from W. Line

Wildcat

Remarks:

Location

Date
JUN 15 1949

Scout **S. J. LEWIS**

Kansas

Wildcat

Map No. K33 Sec. 21 Twp. 32 R. 7WWell No. 1 Dent

Gulf Company

ABANDONED

Contractor

NE/C

E11403

SECTION PLAT

330 Ft. from N. Line Ft. from S. Line330 Ft. from E. Line Ft. from W. Line

			6

Harper County

Location Rig up

Drilling and Remarks:

Cut 4916

RECORD

Cased in., ft.Sand Gas Oil Total Depth 5050

PRODUCTION

1st 24 hrs. Nat. 1st 24 hrs. after shot Gas Cu. Ft.Dry Hole Abandoned

Date

AUG 3 1949

19

S. J. LEWIS

Scout