
DX 78-1

Harper KANSAS

Section 33 Township 32 Range 7W

Well No. 1 Sechler

Company Sinclair

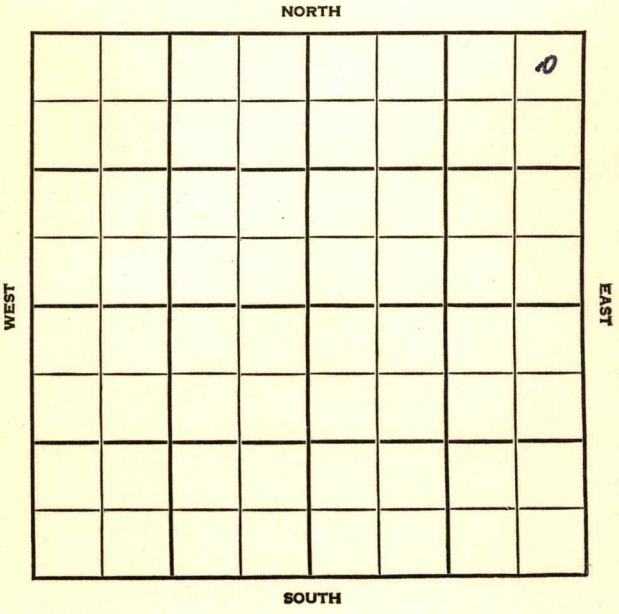

Harper KANSAS

SEC.	TWP.	R.
33	32	7W

WELL NO.
1 Sechler FARM

COMPANY
Sinclair

CONTRACTOR

Banner Pool


330 Ft. from N. Line

Ft. from S. Line

330 Ft. from E. Line

Ft. from W. Line

NE NE NE

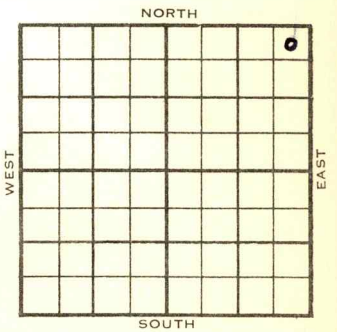

1954

ELEVATION
1407'

REPORT

9/8
10/27

Location

Spud 9-11-54 Oil well TD 5028
10-3/4" @ 276 KC 3872 Miss 4447
DST 4452-74 open 1 hr rec 540' gas, 80' GCM 664#
DST 4474-4505, open 1 hr rec 360' G & OCM, 60' SW. 1286# Kh. 4720
Chattanooga 4792' Viola 4822
DST 4822-35 open 1½ hr rec 60' gas, 30' gassy mud, 69# Simp. 4841'
DST 4833-45 open 3 hr gas in 32 min rec 45' oil, 90' muddy oil, 180' G & OCM 1920#
DST 4841-55 open 3 hr rec 4135' SW Arb. 5006 TD 5027'
DST 5006-27 open 3 hr rec 1980' SW 1920# 7" @ 5027
Schl tops: Miss 4448 Viola 4823 Simp. 4842' Arb. 5004'
TD 5028 CO to 4986 24/4842-44 SSO 750 A S/504 BW 64 BO 24 hrs.
24/4839-41 250 A S/416 BW 24 hr.
18/4841-43 100 M-A S/38 BO 528 BW 24 hrs. Comp. Shut in waiting on water disposal.

COMPLETED

DX-78

FORM 275 FOR SALE BY KANSAS BLUE PRINT CO.

County Harper State Kansas

Sec. 33 (Blk. Twp.) 32 (Sur. Rge.) 7W Map No.

Operator Sinclair

Well No. 1 Farm Sechler

Elev. Location NE NE NE



330 Ft. From N Line NE

330 Ft. From E Line Quarter

1st. Report SEP 8 1954

Completion

Remarks

Spudding Date

Drlg. Data Banner Pool

Location

FABEN GILSTRAP

FORM 275 FOR SALE BY KANSAS BLUE PRINT CO.


County Harper State Kansas

Sec. 33 (Blk. Twp.) 32 (Sur. Rge.) 7W Map No.

Operator Sinclair

Well No. 1 Farm Sechler

Elev. 1407 Location NE NE NE

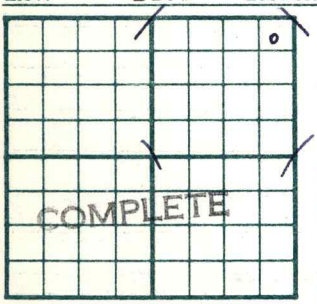

330 Ft. From N Line NE

330 Ft. From E Line Quarter

1st. Report

Completion OCT 27 1954

Remarks Banner Pool

Spudding Date 9-11-54

Drlg. Data Oil well TD 5028

10 3/4" @ 276 KC 3872 Miss. 4447

DST 4452-74 open 1 hr. Rec. 540' gas

80' gcm 664# DST 4474-4505 open 1 hr.

Rec. 360' g & ocm 60' sw 1286#

Kh. 4720 Chattanooga 4792 Viola 4822

DST 4822-35 open 1½ hr. Rec. 60' gas

30' gassy mud 69# Simp. 4841

DST 4833-45 open 3 hr. gas in 32 min.

Rec. 45' oil 90' muddy oil 180' g & ocm

1920# DST 4841-55 open 3 hr. Rec.

4135' sw Arb. 5006 TD 5027 DST 5006-

27 open 3 hr. Rec. 1980' sw 1920#

7" @ 5027 SCHLUMBERGER TOPS

Miss. 4448 Viola 4823 Simp. 4842

FABEN GILSTRAP

Drlg. Data

Arb. 5004 TD 5028 CO to 4986

24/ 4842-44 SSO 750A S/ 504 bw

64 bo 24 hr. 24/ 4839-41 250 A

S/ 416 bw 24 hr. 18/ 4841-43 100 M-A

S/ 38 bo 528 bw 24 hr. Comp.

Shut in waiting on water disposal

