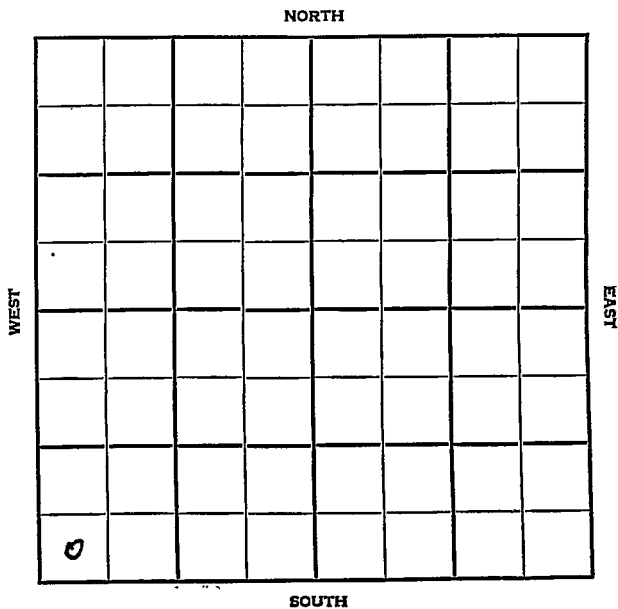


Harper KANSAS

Section 27 Township 32 Range 7WWell No. 1 MoldenhaverCompany Musgrove Pet.

Harper KANSAS

SEC.	TWP.	R.
27	32	7W

WELL NO.

1 Moldenhaver FARM

COMPANY

Musgrove Pet.

CONTRACTOR

Musgrove

Wildcat


Ft. from N. Line

330 Ft. from S. Line

Ft. from E. Line

330 Ft. from W. Line

SW SW SW

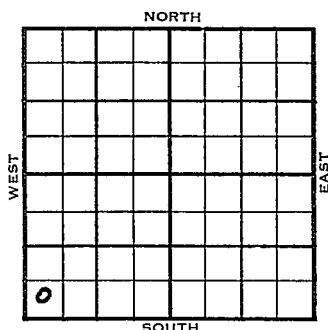

	ELEVATION	REPORT
1954	1402'	

6/30


R U R

7/7

8" @ 217
Elgin 3085' Oread 3248' Heeb 3261'
Doug 3392
Drlg. 3476

9/1

Spud 6-29-54 - Oil Well
TD 5025'
8" @ 217'
Elgin 3085', Oread 3248', Heeb 3261',
Doug 3392', Ians 3874', Miss 4435'
DST 4434-55', opn 1 hr., rec. 335,000
cfg, 110' gcm, 1530#
DST 4455-80', opn 1 hr., gas in 52",
rec. 30' so&gcm, 228' ho&gcm, 1140#
DST 4480-99', opn 1 hr., rec. 45' so &
gcm, 240' sw, 1250#
Kh 4674', Viola 4801', Simp. sh 4818',
Simp. sd 4833'
DST 4849-80', opn 1 hr., rec. 2000' o&
gcm, 2008' sw, 1970#
DST 4867-80', opn 1 hr., rec. 3705'
sw, 1950# Arb. 4994'
TD 5025'
5" @ 5023'
36/4833-39, F/60 bo $\frac{1}{2}$ hr., F/40 boph
Comp. BHB 3000 bopd

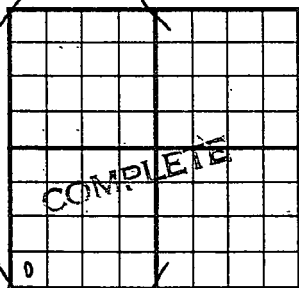County Harper State KansasSec. 27 (Blk.) 32 (Sur.) 7W Map No.Operator Musgrove Pet.Well No. 1 Farm MoldenhaverElev. 1402 Location SW SW SW330 Ft. From S Line SW330 Ft. From W Line Quarter

1st. Report

Completion SEP 1 1954Remarks WildcatMusgrove - Contr.Spudding Date 6-29-54Drlg. Data Oil well TD 50258" @ 217 Elgin 3085 Oread 3248Heeb. 3261 Doug. 3392 Lans. 3874Miss. 4435 DST 4434-55 open 1 hr.Rec. 335,000 c/g 110' gcm 1530#DST 4455-80 open 1 hr. gas in 52 min.Rec. 30' so & gcm 228' ho & gcm 1140#DST 4480-99 open 1 hr. Rec. 45' so &gcm 240' sw 1250# Kh. 4674Viola 4801 Simp. sh. 4818 Simp. sd. 4833DST 4849-80 open 1 hr. Rec. 2000' o &gcs. 2008' sw 1970# DST 4867-80open 1 hr. Rec. 3705' sw 1950#Arb. 4994 TD 5025 5" @ 502336/ 4833-39 F/ 60 bo $\frac{1}{2}$ hr. F/ 40 bophComp. BHB 3000 bopd

FABEN GILSTRAP

County **Harper** State **Kansas**

Sec. **27** (Blk. **32** (Sur. **77** Map No.

Operator **Musgrove Pet.**

Well No. **1** Farm **Moldenhaver**

Elev.	Location	SW SW SW
-------	----------	----------

FIRST REPORT

330 Ft. From S Line SW r

350 Ft. From W Line Quarter

1st. Report **JUN 30 1954**

Completion

Remarks

Musgrove - Contr.

Spudding Date _____

Drig. Data Wildcat

R U R