
DX 78-1

Harper KANSAS

Section 27 Township 32 Range 7 W

Well No. # 2 Moldenhauer

Company Musgrove Petroleum

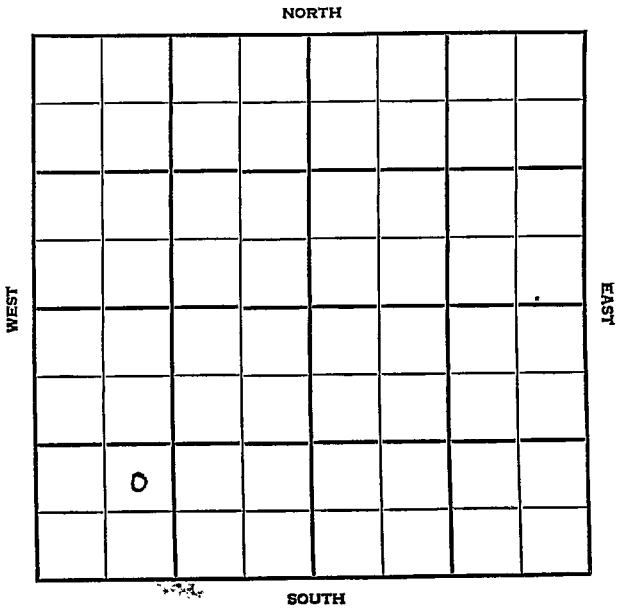

Harper KANSAS

SEC.	TWP.	R.
27	32	7W

WELL NO. #2 Moldenhauer FARM

COMPANY Musgrove Pet.

CONTRACTOR Co. Tools.

Banner Pool


_____ Ft. from N. Line

990 Ft. from S. Line

_____ Ft. from E. Line

990 Ft. from W. Line

NE SW SW

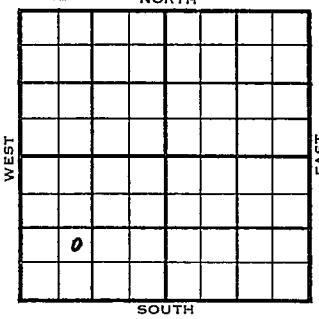

	ELEVATION	REPORT
1954	1403'	
12/29	M I R	
1955 4/27	Spud 12-28-54 Oil well TD 4899 8^{ft} @ 218 Heeb 3270 Doug 3404' Stal. 3650 KC 3880 Miss 4446 Kh. 4730 Viola 4837 Simp 4854 TD 4899 5" @ 4898 CO to 4899 26/4837-45 150 A F/7½ BOPH 10% wtr 10 hr. Comp. 82 BOPD 72% Wtr. COMPLETED	

DX-78

FORM 275 FOR SALE BY KANSAS BLUE PRINT CO.


County Harper State Kansas

Sec. 27 (Blk. Twp.) 32 (Sur. Rge.) 7W Map No.

Operator Musgrove Petroleum

Well No. 2 Farm Moldenhauer

Elev. Location NE SW SW

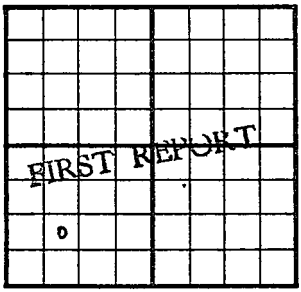

990 Ft. From S Line SW

990 Ft. From W Line Quarter

1st. Report DEC 29 1954

Completion

Remarks

Co. tools

Spudding Date

Drlg. Data

Banner Pool

M I R

FABEN GILSTRAP

FORM 275 FOR SALE BY KANSAS BLUE PRINT CO.


County Harper State Kansas

Sec. 27 (Blk. / Twp.) 32 (Sur. / Rge.) 7W Map No.

Operator Musgrove Pet.

Well No. 2 Farm Moldenhauer

Elev. 1403 Location NE SW SW

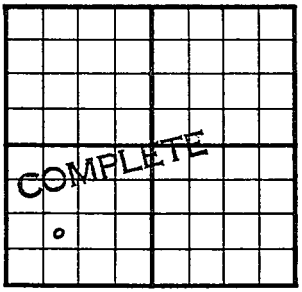

990 Ft. From S Line SW

990 Ft. From W Line Quarter

1st. Report

Completion APR 27 1955

Remarks Banner Pool Co. tools

Spudding Date 12-28-54

Drlg. Data Oil well TD 4899

8" @ 218 Heeb. 3270 Doug. 3404

Stal. 3650 KC 3880 Miss. 4446

Kh. 4730 Viola 4837 Simp. 4854

TD 4899 5" @ 4898 CO to 4899

26/ 4837-45 150 A F/ 7½ boph 10% wtr.

10 hr. Comp. 82 bopd 72% wtr.

FABEN GILSTRAP