
DX 78-1

Harper KANSAS

Section 27 Township 32 Range 7W

Well No. 1 Ruffolo

Company Morrison Drlg. Co.

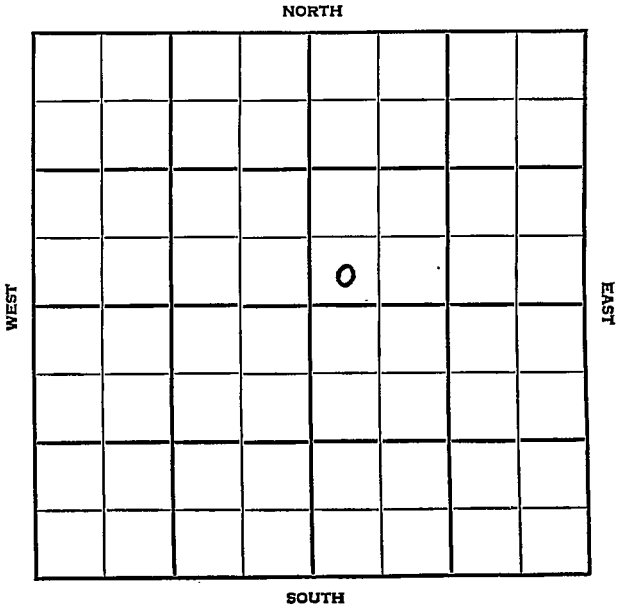

Harper KANSAS

SEC.	TWP.	R.
27	32	7W

WELL NO.

1 Ruffolo FARM

COMPANY

Morrison Drlg. Co.

CONTRACTOR


Musgrove
Banner Pool

_____ Ft. from N. Line

330 Ft. from S. Line

_____ Ft. from E. Line

330 Ft. from W. Line

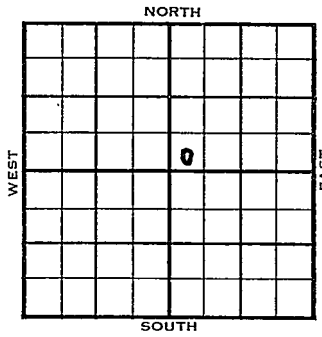

SW SW NE
Gufl DHM

1954	ELEVATION 1408'	REPORT
9/22	Spud 9-14-54 10" @ 220' Drlg. 2589'	
10/13	Spud 9-14-54 D & A TD 4865 10" @ 220 Lans: 3875' Miss 4438 DST 4425-70 open 3 hr gas in 1 hr 50 mins, rec 795' HG & SOCM, 120' muddy wtr. 1425# Kh. 4726' Viola 4838', Simp. 4847' DST 4846-57 open ½ hr rec 3180' SW 1935# TD 4865' D & A	
		ABANDONED

DX-78

FORM 275 FOR SALE BY KANSAS BLUE PRINT CO.


County Harper State Kansas

Sec. 27 (Blk. Twp.) 32 (Sur. Rge.) 7W Map No.

Operator Morrison Drlg. Co.

Well No. 1 Farm Ruffolo

Elev. Location SW SW NE

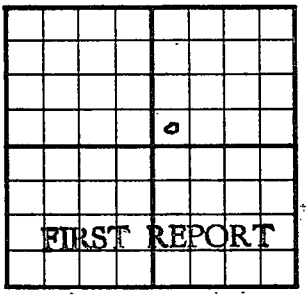

330 Ft. From S Line NE

330 Ft. From W Line Quarter

1st. Report SEP 22 1954

Completion

Remarks Gulf DHM

Musgrove Tools

Spudding Date 9/14/54

Drlg. Data Banner Pool

10" @ 220. Drlg 2589

FABEN GILSTRAP

FORM 275 FOR SALE BY KANSAS BLUE PRINT CO.


County Harper State Kansas

Sec. 27 (Blk. Twp.) 32 (Sur. Rge.) 7W Map No.

Operator Morrison Drlg.

Well No. 1 Farm Ruffalo

Elev. 1408 Location SW SW NE

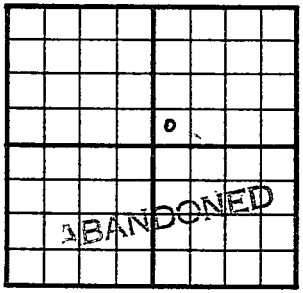

330 Ft. From S Line NE

330 Ft. From W Line Quarter

1st. Report

Completion OCT 13 1954

Remarks Banner Pool
Musgrove - Contr.

Spudding Date 9-14-54

Drlg. Data D & A TD 4865

10" @ 220 Lans. 3875 Miss. 4438

DST 4425-70 open 3 hr. gas in 1'50"

rec. 795' hg & socm 120' muddy wtr.

1425# Kh. 4726 Viola 4838 Simp. 4847

DST 4846-57 open ½ hr. Rec. 3180' sw

1935# TD 4865

D &A

FABEN GILSTRAP