
Harper KANSAS

SECTION 34 TOWNSHIP 32 RANGE 7 W

WELL NO. #1 Bartlett

COMPANY Graybol

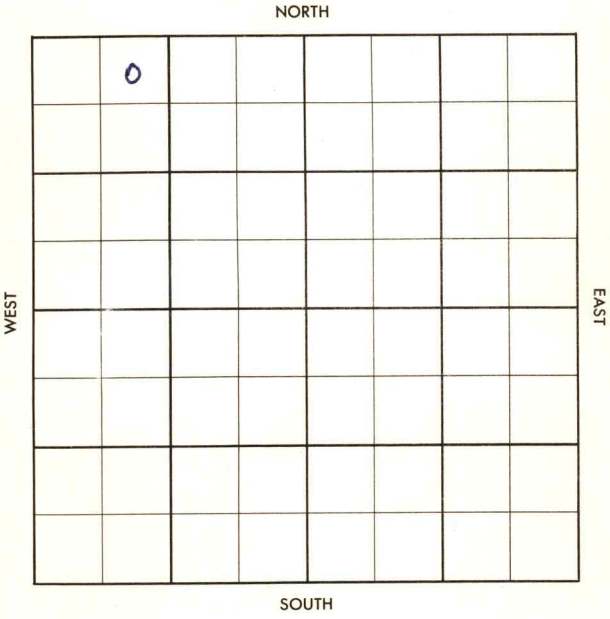

FORM 504-3 SUNRAY

Harper KANSAS

SEC.	TWP.	R.
34	32	7W

WELL NO.

#1 Bartlett FARM

COMPANY

~~###~~ Graybol

CONTRACTOR

Co. Tools

Banner


_____ Ft. from N. Line

_____ Ft. from S. Line

_____ Ft. from E. Line

_____ Ft. from W. Line

NE NW NW

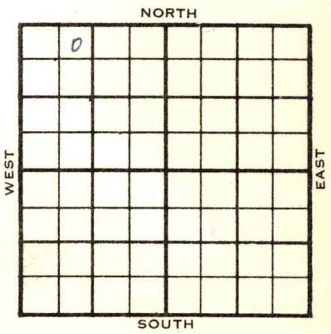

1956	ELEVATION REPORT
1-18	Comm. 1-15-56 10" @ 227 Drlg. 1001

DX-78

FORM 513 REV. SUNRAY

County Harper Elev.

Sec. 34 Twp. 32 Rge. 7W

Company Graybol

Farm Name Bartlett No. 1

TOPS	DEPTH	LOG	DATUM
Anh.			
Tp.			
H.			
Tr.			
Dg.			
B.L.			
L.			
K.C.			
B.K.C.			
Ce.			
C.			
M.			
M.			
K.			
Mz.			
Mo.			
V.			
S.			
S.			
A			
R.			
P€.			
G.			
T.D.			

Loc. in Sec. NE NW NW

Geol.

Contr. Co. tools

Pool Banner



Date Comm. 1-15-56

10" @ 227 drlg. 1001

27

Co. Lse. No. Sec. T. R.

FORM 313 REV. SUNRAY

County Harper Elev.

Sec. 34 Twp. 32 Rge. 7W

Company Graybol

Farm Name Bartlett No. 1

TOPS	DEPTH	LOG	DATUM
Ank.			
Tp.			
H.			
Tr.			
Bp. Sd	3630		
Bl.			
L.	3893		
Kc.			
B.K.	4212		
Ce. Ft Sct	4352		
C.			
M.	4450		
M.			
K.			
Mo.			
Mo.			
V.	4833		
S.	4838		
S.			
A.			
R.			
Pe.			
B.			
TD	4853		

Loc. in Sec. NE NW NW

Geol.

Contr. Co. tools

Pool Banner

ABANDONED

FEB 15 1956

Date Comm. 1-15-56

10" @ 227 drlg. 1001 JAN 25 56 Ø 3040

FEB 1 56 Ø 4375 FEB 8 56 DST

4445-70 90" 9 in 12" TSTM

ac 95' SGCM BHP 1420/20

DST 4470-4600 90" ac 240'

SOE GCM +210' SW BHP 1400/20

crd 4810-28 Full Rec DST

4822-30 lhs ac 8' Ø Md

BHP 0/20 crd 4830-42 Full Rec

DST 4838-42 2hr gsm 14"
rec 1520' oil + 460' SW
no press. FEB 18 56 DST 4840-42
op 2 hrs rec 310' oil +
360' SW BHP 1945/20
crd 4842-53 Full Rec

M. & A

(Couldn't seperate oil & wtr)

R. G.

FEB 27 1956