

WELL COMPLETION REPORT AND DRILLER'S LOG


State Geological Survey
WICHITA BRANCH

S. 4 T. 32 R. 8 

Loc. C SE SE

County Harper

640 Acres
M

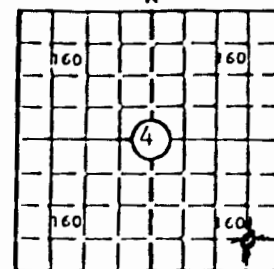

Locate well correctly

Elev.: Gr. 1457

DF 1467 KB 1469

API No. 15 — 077 — 20,719
County Number

Operator

Dunne-Gardner Petroleum, Inc.

Address

Suite 250, 200 W. Douglas, Wichita, Kansas 67202

Well No.

1

Lease Name

Burns

Footage Location

660 feet from (M) (S) line

660 feet from (E) (W) line

Principal Contractor

Dunne-Gardner Rig #2

Geologist

Sherry Heathman

Spud Date

9/7/81

Date Completed

9/15/81

Total Depth

4447 LTD

P.B.T.D.

Directional Deviation

Oil and/or Gas Purchaser

CASING RECORD

Report of all strings set — surface, intermediate, production, etc.

Purpose of string	Size hole drilled	Size casing set (in O.D.)	Weight lbs/ft.	Setting depth	Type cement	Socks	Type and percent additives
Surface casing		8-5/8"		215'		150	

LINER RECORD

PERFORATION RECORD

Top, ft.	Bottom, ft.	Sacks cement	Shots per ft.	Size & type	Depth interval

TUBING RECORD

Size	Setting depth	Packer set at			

ACID, FRACTURE, SHOT, CEMENT SQUEEZE RECORD

Amount and kind of material used	Depth interval treated

INITIAL PRODUCTION DRY

Date of first production		Producing method (flowing, pumping, gas lift, etc.)			
RATE OF PRODUCTION PER 24 HOURS		Oil	Gas	Water	Gas-oil ratio
		bbls.	MCF	bbls.	CFPB
Disposition of gas (vented, used on lease or sold)			Producing interval(s)		

INSTRUCTIONS: As provided in KCC Rule 82-2-125, within 90 days after completion of a well, one completed copy of this Drillers Log shall be transmitted to the State Geological Survey of Kansas, 4150 Monroe Street, Wichita, Kansas 67209. Copies of this form are available from the Conservation Division, State Corporation Commission, 245 No. Water, Wichita, Kansas 67202. Phone AC 316-522-2206. If confidential custody is desired, please note Rule 82-2-125. Drillers Logs will be on open file in the Oil and Gas Division, State Geological Survey of Kansas, Lawrence, Kansas 66044.

Operator Dunne-Gardner Petroleum, Inc.		DESIGNATE TYPE OF COMP.: OIL, GAS, DRY HOLE, SWOW, ETC.:
Well No. 1	Lease Name Burns	Dry Hole
4 T 32 R 8 ^E / _W		


WELL LOG

Show all important zones of porosity and contents thereof; cased intervals, and all drill-stem tests, including depth interval tested, cushion used, time tool open, flowing and shut-in pressures, and recoveries.

SHOW GEOLOGICAL MARKERS, LOGS RUN, OR OTHER DESCRIPTIVE INFORMATION.

FORMATION DESCRIPTION, CONTENTS, ETC.	TOP	BOTTOM	NAME	DEPTH
DST #1 4017-4027 (Lansing - Kansas City) 30-60-60-60, recovered 700' mud FP 33-33/137-343#* SIP 1982*-1638# HP 2006-1985# BHT 127° *Pressures questionable due to plugging action			Electric Log Tops	
DST #2 4365-4379 (Mississippian) 30-60-60-60, recovered 5' heavy oil cut mud (40% oil, 60% mud), 150' oil cut watery (4% oil, 30% water), 300' gas cut muddy salt water FP 106-174/219-269# SIP 1477-1467# HP 2320-2278# BHT ---			Indian Cave Heebner Itan Stalnaker Kansas City Stark B/Kansas City Cherokee Mississippian RTD LTD	2372 (-903) 3323 (-1854) 3570 (-2101) 3616 (-2147) 3880 (-2411) 4006 (-2537) 4074 (-2605) 4255 (-2786) 4364 (-2895) 4425 (-2956) 4427 (-2978)

USE ADDITIONAL SHEETS, IF NECESSARY, TO COMPLETE WELL RECORD.

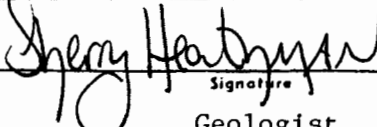Date Received	 Signature Geologist Title January 11, 1982 Date
---------------	---