

8-32-948

TYPE

AFFIDAVIT OF COMPLETION FORM

ACO-1 WELL HISTORY

SIDE ONE

Two (2) copies of this form shall be filed with the Kansas Corporation Commission, 200 Colorado Derby Building, Wichita, Kansas 67202, within thirty (30) days after the completion of a well, regardless of how the well was completed.

Attach separate letter of request if the information is to be held confidential. If confidential, only file one copy. Information on Side One will be of public record and Side Two will then be held confidential.

Applications must be made on dual completion, commingling, salt water disposal, injection and temporarily abandoned wells.

Attach one copy only wireline logs (i.e. electrical log, sonic log, gamma ray neutron log, etc.). (Rules 82-2-105 & 82-2-125) KCC# (316) 263-3238.

LICENSE # 5041 EXPIRATION DATE 6-30-83

OPERATOR Ram Petroleum Corporation API NO. 15-077-20,610

ADDRESS 1260 KSB&T Bldg. COUNTY Harper

Wichita, Kansas 67202 FIELD Sharon East

** CONTACT PERSON Robt K. Edmiston PROD. FORMATION Mississippi
PHONE (316) 265-5241

PURCHASER (oil) Koch (gas) KS Gas Supply LEASE Davis "A"


ADDRESS P.O. Box 2256 Box 300 WELL NO. #1
Wichita, KS 67201 Tulsa, OK 74102

DRILLING Union Drilling 330 Ft. from North Line and

CONTRACTOR 422 Union Center Bldg. 990 Ft. from West Line of

ADDRESS Wichita, Kansas 67202 the SW (Qtr.) SEC 8 TWP 32 RGE 9W

PLUGGING CONTRACTOR ADDRESS

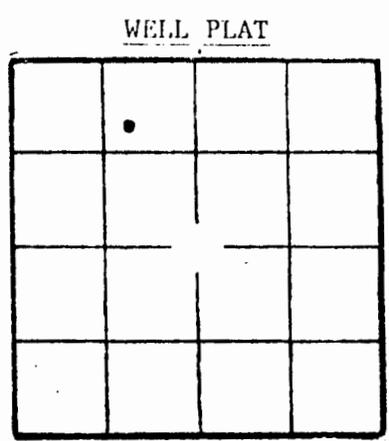

(Office Use Only) KCC KGS SWD/REP PLG.

TOTAL DEPTH 4402 PBD 4382

SPUD DATE 8-29-80 DATE COMPLETED 10-12-80

ELEV: GR 1469 DF KB 1474

DRILLED WITH (CABLE) (ROTARY) (AIR) TOOLS.

DOCKET NO. OF DISPOSAL OR REPRESSURING WELL BEING USED TO DISPOSE OF WATER FROM THIS LEASE

Amount of surface pipe set and cemented 290' DV Tool Used? no

THIS AFFIDAVIT APPLIES TO: (Circle ONE) - Oil, Gas, Shut-in Gas, Dry, Disposal, Injection, Temporarily Abandoned, OWWO. Other

ALL REQUIREMENTS OF THE STATUTES, RULES AND REGULATIONS PROMULGATED TO REGULATE THE OIL AND GAS INDUSTRY HAVE BEEN FULLY COMPLIED WITH.

RECEIVED STATE CORP. FEB 1 1983

A F F I D A V I T

Robt K. Edmiston, being of lawful age, hereby certifies that:

I am the Affiant, and I am familiar with the contents of the foregoing Affidavit. The statements and allegations contained therein are true and correct.

WP-55*8
 SIDE TWO
 OPERATOR Ra

Petroleum Corporation LEASE Davis "A" - 1 SEC. 8 TWP. 32 RGE. 9W

ACO-1 WELL HISTORY

FILL IN WELL LOG AS REQUIRED:

FORMATION DESCRIPTION, CONTENTS, ETC.			TOP	BOTTOM	NAME	DEPTH
Redbed			0	226	Mississippi LTD	4324 (-2850)
Redrock & redbed			226	290		4402 (-2928)
Shale			290	3333		
Shale & Lime			3333	3803		
Lime & Shale			3803	3941		
Lime			3941	4332		
Lime & Chert			4332	4342		
Lime			4342	4402		
RTD				4402		

ACID, FRACTURE, SHOT, CEMENT SQUEEZE RECORD			
Amount and kind of material used			Depth interval treated
300 Gal., 15% Demud			4328-4338
Frac. 35,000 (20/40) 5,000 (10/20 sd.)			4328-4338
Date of first production	Producing method (flowing, pumping, gas lift, etc.)		Gravity
RATE OF PRODUCTION PER 24 HOURS	Oil 10 bbls.	Gas 67 MCF	Water 33 % 5 bbls.
Perforations			20

* NOTE: Edmiston Oil Company, Inc., operates this well from the casing point.

Report of all strings set — surface, intermediate, production, etc. CASING RECORD (New) or (Used)							
Purpose of string	Size hole drilled	Size casing set (in O.D.)	Weight lbs./ft.	Setting depth	Type cement	Socks	Type and percent additives
Surface	12-1/4	8-5/8		285	Common	250	2% gel, 3% cc
Production		4-1/2	9.5	4401	50/50 posmix	220	
LINER RECORD				PERFORATION RECORD			
Top, ft.	Bottom, ft.	Socks cement		Shots per ft.	Size & type	Depth interval	
TUBING RECORD				2		4328-4338	
Size	Setting depth	Packer set at					