
DX 78-1

Harper KANSAS

Section 3 Township 32 Range 9W

Well No. 1 Dusenbury

Company Wakefield et al

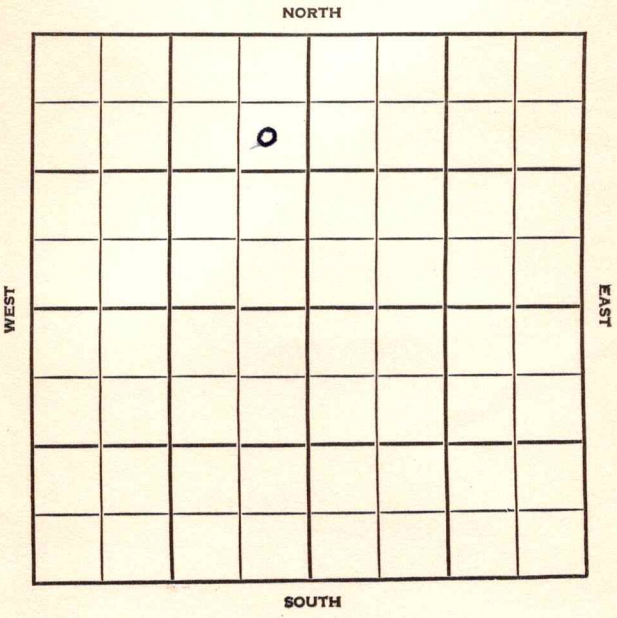

Harper KANSAS

SEC.	TWP.	R.
3	32	9W

WELL NO.

1 Dusenbury FARM

COMPANY

Wakefield et al

CONTRACTOR

Wakefield


Wildcat

990 Ft. from N. Line

Ft. from S. Line

330 Ft. from E. Line

Ft. from W. Line

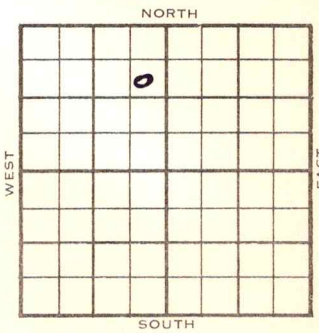

SE NE NW

Carter FO & DHM

1954	ELEVATION 1623' REPORT
6/15	Loc.
6/23	8" @ 200 Drlg. 3355'
7/7	" ?
1955 1/12	Spud 6-14-54 Oil well TD 4525' 8" @ 200 Doug 3565' Lans 3717' KC 3982 Miss 4432 DST 4434-50 open 70 min, 1 MCFG, 55' HO & GCM, 35' VHO & GCM, 1642# DST 4450-65, open 1 hr rec 125' VHO & GCM, 15' wtr. 693# DST 4465-4500, open 1 hr rec 450' O & GCM, 150' wtr. 1112# TD 4525' 5" @ 4525 CO to 4496 60/4443-61 S/5 to 10 BO 500,000 CFG 24 hr. F/5 BOPH 15% wtr. ½ MCFG CO to 4502 72/4469-87 FU 1300' wtr. 17 hr. SP 4464 60/4434-43 FU 25' oil, 10' wtr. 14 hr. 300,000 CFG 250 M-A SD 12 hr. A-frac 2 BO 29 BW 8 hr. Comp. 4 or 5 BOPD COMPLETED

DX-78

FORM 275 FOR SALE BY KANSAS BLUE PRINT CO.

County Harper State Kansas

Sec. 3 (Blk. Twp.) 32 (Sur. Rge.) 9W Map No.

Operator Wakefield etal.

Well No. 1 Farm Dusenbury

Elev. Location SE NE NW



990 Ft. From N Line NW

330 Ft. From E Line Quarter

1st. Report JUN 15 1954

Completion

Remarks Carter FO & DHM
Wakefield - Contr.

Spudding Date

Drlg. Data Wildcat

J. G. McGEHEE

FORM 275 FOR SALE BY KANSAS BLUE PRINT CO.


County Harper State Kansas

Sec. 3 (Blk. Twp.) 32 (Sur. Rge.) 9W Map No.

Operator Wakefield etal.

Well No. 1 Farm Dusenbury

Elev. 1623 Location SE NE NW

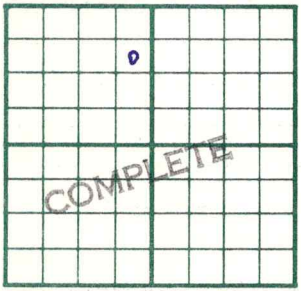

990 Ft. From N Line NW

330 Ft. From E Line Quarter

1st. Report

Completion JAN 1 2 1955

Remarks Wildcat

Wakefield - Contr.

Spudding Date 6-14-54

Drlg. Data Oil well TD 4525

8" @ 200 , Doug.3565 Lans. 3717

KC 3982 Miss. 4432 DST 4434-50

open 70 min. 1 mcfg 55' ho & gcm

35' vho & gcm 1642# DST 4450-65

open 1 hr. Rec. 125' vho & gcm 15' wtr.

693# DST 4465-4500 open 1 hr. Rec.

450' o & gcm 150' wtr. 1112#

TD 4525 5" @ 4525 CO to 4496

60/ 4443-61 S/ 5 to 10 bo 500,000 cfg

24 hr. F/ 5 boph 15% wtr. $\frac{1}{2}$ mcfg

CO to 4502 72/ 4469-87 FU 1300' wtr.

17 hr. SP 4464 60/ 4434-43 FU 25' oil

10' wtr. 14 hr. 300,000 cfg 250 M-A

SD 12 hr. A-frac 2 bo 29 bw 8 hr.

FABEN GILSTRAP

Drlg. Data

Comp. 4 or 5 bopd

JAN 18 1955

Scout Cards
Land Small Map
Land Wall Map
Tabings
France Map
Pierce Map
Misc.