


Section 3 Township 32 Range 9W

Well No. 1 J. Maroney

Company C. J. Brown

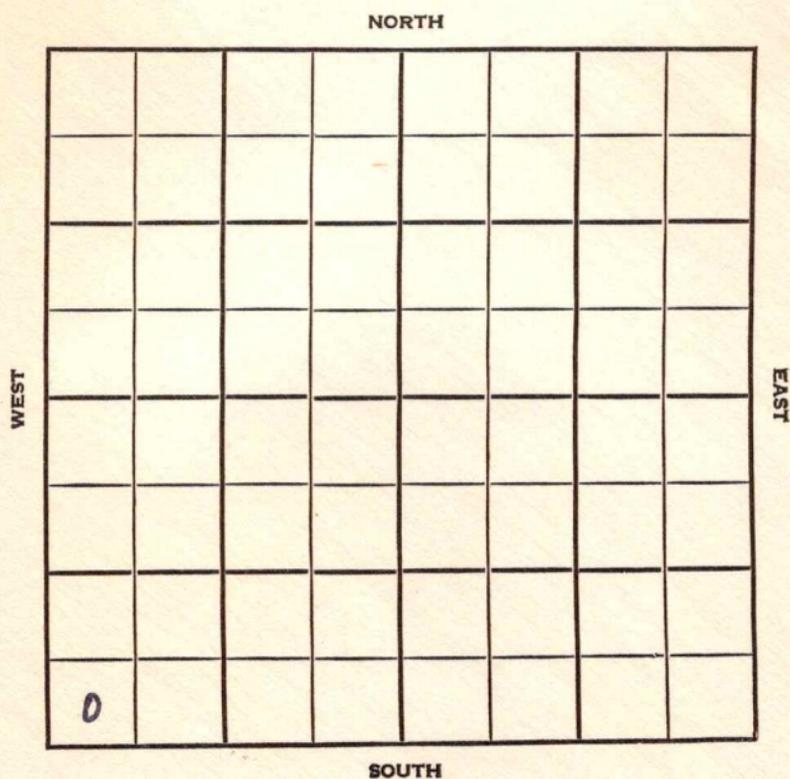

Harper KANSAS

SEC.	TWP.	R.
3	32	9W

WELL NO. \_\_\_\_\_  
 1 J. Maroney FARM

COMPANY \_\_\_\_\_  
 C. J. Brown

CONTRACTOR \_\_\_\_\_  
 Anschutz


Wildcat

\_\_\_\_\_ Ft. from N. Line

330 \_\_\_\_\_ Ft. from S. Line

\_\_\_\_\_ Ft. from E. Line

330 \_\_\_\_\_ Ft. from W. Line

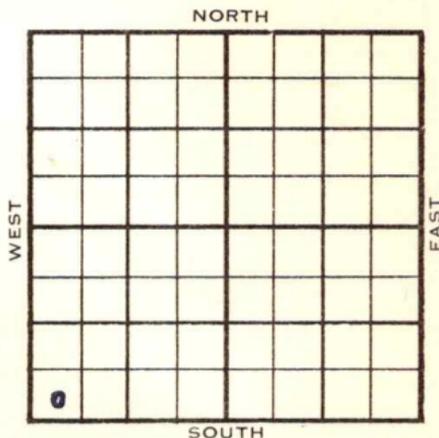

SW SW SW

Carter AC & DHM

	ELEVATION	REPORT
1955	1504'	
2/16	Spud 2-13-55 8" @ 199' Drlg. 1580'	
4/13	Spud 2-13-55 D & A TD 4436 8" @ 199 Heeb 3410 Lans 3618 Miss 4361 DST 4359-71 open 1 hr gas in 33 min rec 30' SO & GCM 30' O & GCM, 60' gassy oil 1520# DST 4371-81 open 1 hr rec 42' VSGCM DST 4375-86 open 1 hr rec 540' gas, 35' VSO & GCM, 150# DST 4384-4406 open 1 hr rec 360' gas, 25' SO & GCM, 120# Schl tops: Heeb 3411, Lans 3620', KC 3908', B KC 4158', Miss 4363', TD 4383' DD 4436 5" @ 4391 32/4362-66 16/4370-72 B/1/2 BOPH Sd-oil-frac. P/37 BO 2% SW 20 1/2 hr. P/12 BO 2% SW D & A	

**ABANDONED**



