

SECTION 7 - TOWNSHIP 32 RANGE 9 W

WELL NO. #1 Stone

COMPANY Pickrell Drlg.

NORTH

	0						

WEST

EAST

SOUTH

SEC.	TWP.	R.
7 - -	32	9W

WELL NO. #1 Stone FARM

COMPANY Pickwell Drlg.

CONTRACTOR Co. tools


WILDCAT

_____ Ft. from N. Line

_____ Ft. from S. Line

_____ Ft. from E. Line

_____ Ft. from W. Line

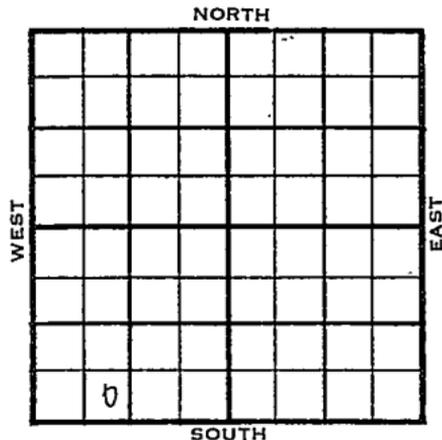

SE SW SW

Durbin-Bond - DHM

	ELEVATION	REPORT
1956	11461	
1-25	RUR	
3-21	Comm. 1-26-56 8 5/8" @ 200/200 DST 4340-48 op 1 1/2 hr. rec. 50' ho&gcm 475' muddy oil, 5' wtr., 1540"/20" DST 4350-60 op 1 hr. gas in 5 min, 60 mcfg, 4350' oil, 1840/20" 5 1/2" @ 4350/100 CO to 4360, F/ 60 boph, 3 hrs., F/ 180 bo 12 hrs. Comp. F/ 71 bopd. H. 3393 Dg. sd 3470 2nd Sd. 3514 L. 3607 M. 4338 TD 4360'	

COMPLETED

County Harbor

Elev. _____

Sec. 7

Twp. 32

Rge. 9W

Company Pickrell Drlg.

FarmName Stone

No. 1

TOPS	DEPTH	LOG	DATUM
Anb.			
Tp.			
H.			
Tr.			
Dg.			
BL.			
L.			
K.C.			
B.K.C.			
Ce.			
C.			
M.			
M.			
K.			
Mz.			
Me.			
V.			
S.			
S.			
A			
R.			
PE.			
G.			
TR.			

Loc. in Sec. _____

SE SW SW

Geol. _____

Contr. _____

Co. tools

Pool _____

Wildcat

FIRST REPORT

JAN 25 1956

0

Date Comm. _____

RUR

Durbin-Bond - DHM

27

Co.

Lse.

No.

Sec.

T.

R.

County Hamber Elev. 1461
 Sec. 7 Twp. 32 Rge. 9W
 Company Fickrell Drlg.
 FarmName Stone No. 1

TOPS	DEPTH	LOG	DATUM	Loc. in Sec.
Anh.				SE SW SW
Tr.				
Dg. <u>sd</u>	<u>3393</u>			
Bt. <u>2nd sd</u>	<u>3470</u>		<u>2009</u>	
L.	<u>3514</u>		<u>2059</u>	
K.C.	<u>3607</u>		<u>2146</u>	Geol.
B.K.C.				Contr.
Ce.				Co. tools
C.				Pool
M.	<u>4338</u>		<u>2877</u>	
M.				
K.				
Mz.				
Ma.				
V.				
S.				
S.				
A.				
R.				
PE.				
G.				
T.D.	<u>4360</u>			

COMPLETE

Date Comm. 1-26-56 MAR 21 1956
8 5/8" @ 200/200 DST 4340-48
open 1 1/2 hr. rec. 50' ho & gcm 475'
muddy oil 5' wtr. 1540#/20"
DST 4350-60 open 1 hr. gas in 5 min.
60 mcfg 4350' oil 1840/20"
5 1/2" @ 4350/100 CO to 4360 F/ 60 boph
3 hr. F/ 180 bo 12 hr.
Comp. F. 71 bopd