


Harper

KANSAS

SECTION 7 TOWNSHIP 32S RANGE 9W

WELL NO. #2 Koerner

COMPANY Durbin Bond

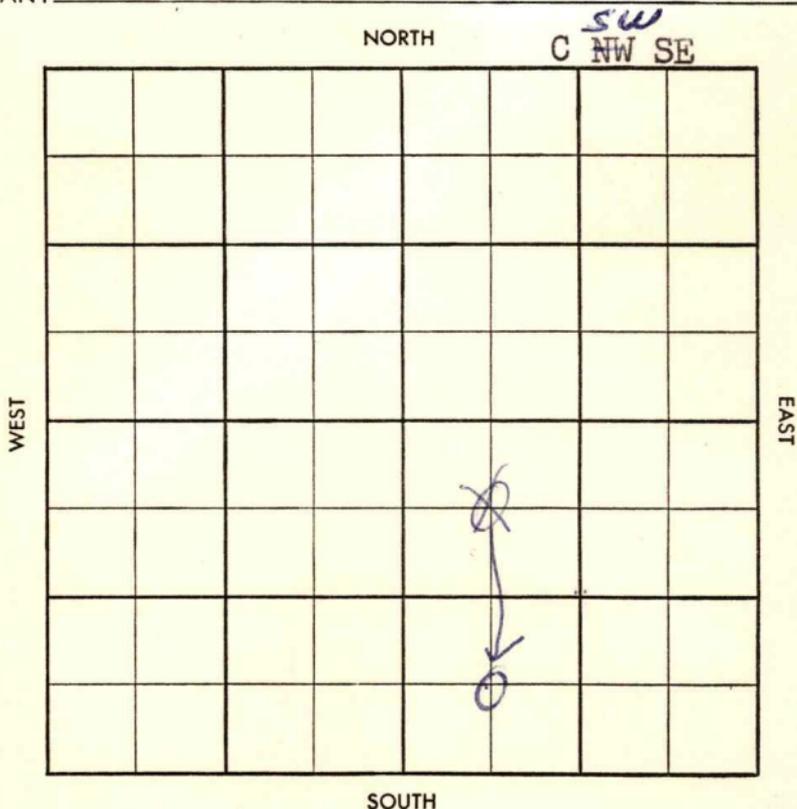

Our maps show #3 Koerner at C SW SE where this #2 has been corrected to. Will you please check and advise on this as the #2 was FR as NW SE and the #3 as the C SW SE. Thanks.

Sam Baird

Will you also please ask the Scout to just put one line thru the original location, well number, etc. when he corrects them, as both we and the drafting section are experiencing quite a lot of difficulty determining the original spots, numbers, etc. when he scratches them out completely. Thank

Also, please ask the Scout to put the TD of the well in the bottom of the boxed-in space on the completion tickets, because the drafting boys have to read all the completion information in order to find the TD and this takes up ~~xxx~~ a lot of time while they are trying to get these posted to the maps. The TD used to be carried in this place on the ticket and we will appreciate it very much if he will put there so they will be able to find it easily. Thanks again.

The #3 Koerner has been corrected from the C SW SE to C NW SE.
The #2 Koerner has been corrected from C NW SE to C SW SE.

21

S-513-A

CO. ~~Harper~~ ELEV. _____

SEC. ~~7~~ TWP. 32 RGE. 9W

COMPANY Durbin Bond NO. 2

FIRST REPORT

OCT 30 '57

FARM Koerner

LOC. C NW SE

GEOL. _____

CONTR. J-S-F tools #5

POOL Sharon

SPUD 10-27-57

8" @ 240 w/275, Drlg. 950

CO.

LSE.

NO.

SEC.

TWP.

RGE.