

Harper

KANSAS

7

32S

9W


SECTION _____ TOWNSHIP _____ RANGE _____

#3 Koerner

WELL NO. _____

Durbin Bond

COMPANY _____

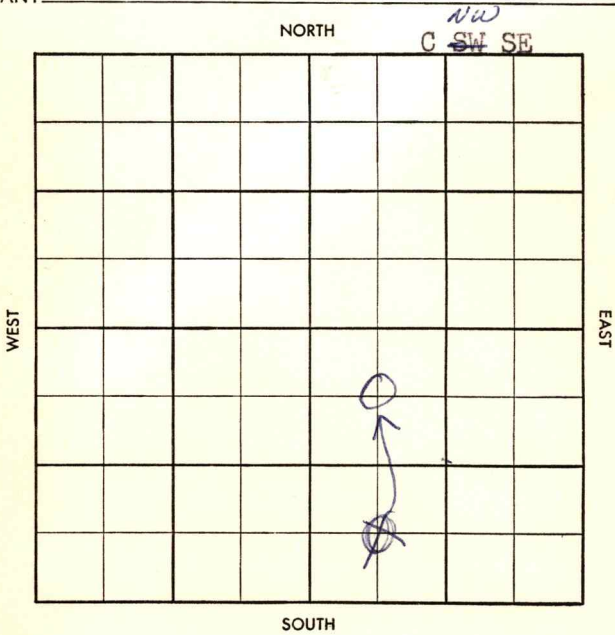

CO. Harper ELEV. _____SEC. 7 TWP. 32 RGE. 9WCOMPANY Durbin Bond NO. 3

NOV 13 1957

FIRST REPORT

FARM KoernerLOC. C SW SE

GEOL. _____

CONTR. J-S-FPOOL SharonSPUD 10-11-578" @ 235/225drlg. 1130

CO.

LSE.

NO.

SEC.

TWP.

RGE.

22

27
CORRECTION

CO. Harper ELEV. 14660
 SEC. 7 TWP. 32 RGE. 9W
 COMPANY Durbin Bond NO. 3

COMPLETE

DEC 26 '57

FARM KoernerLOC.  275
CNWSE

GEOL.

CONTR. J-S-FPOOL SharonSPUD 10-11-57

8" @ 235/225

dr/c. 1130

NOV 20 '57

3765

NOV 27 '57

L 3608

M 4310 DST

4312 - 28 60"

g/l 2" stat 5.020 mcf 140"

5' HOC M BHP 1540 DST

4332 - 43 90" 80' 50' GCM

FP 0-40 BHP 640/20" DST

4340 - 47 90" 1350' oil

NW FP 75-400 BHP 1495

RTD 4347 5" 4340 WOC

DEC 4 '57 CO 4347 TD

6 BOPH + 890 W 8 hrs

max PAP

DEC 26 '57

Phy 86 BOP & NW
gr 30°