


SECTION 8 TOWNSHIP 32 RANGE 9W

WELL NO. #1 Kloefkorn

COMPANY Pickrell Drlg. Co.

NORTH

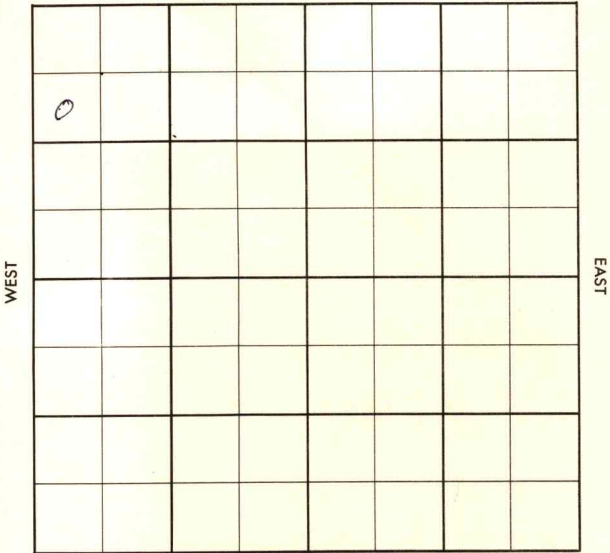

SOUTH

WEST

EAST

County Harper Elev. 1478
 Sec. 8 Twp. 32 Rge. 9W
 Company Pickrell Drlg. Co.
 Farm Name Kloefkorn No. 1

TOPS	DEPTH	LOG	DATUM	Loc. in Sec.
Anh.				SW NW NW
Tr.				
H.	3396			
Tr.				
Dg.				
BL.				
L.	3601			Geol.
K.C.				Contr.
B.K.C.				
Ce.				Co. Tools
C.				
M.	4344			Pool
M.				
K.				
Mz.				
Me.				
V.				
S.				
S.				
A.				
R.				
PE.				
G.				
TD.	4448			

OCT 3 '56
 ABANDONED

Date Comm. 9-14-56 , Sohio FO

8" @ 200 w/125, Drlg. 2550 SEP 26 '56

IP 4170 OCT 3 '56 DST 4346-60 90"
G/30" rec 35' GCM FPO BHP
765 DST 4360-85 of 90" rec
540 GIR + 50' oil sptd Md
BHP 95 DST 4388-4400
90" G/55" rec 120' oil sptd
Md + 240' SW BHP 1440
DEA

County Harper Elev. _____
 Sec. 8 Twp. 32 Rge. 9W
 Company Pickrell Drlg. Co.
 Farm Name Kloefkorn No. 1

TOPS	DEPTH	LOG	DATUM	Loc. in Sec.
Anh.				SW NW NW
Tp.				
H.				
Tr.				
Dg.				
Bl.				
L.				Geol. _____
K.C.				Contr. _____
B.K.C.				Co. Tools _____
Ce.				
C.				Pool _____
M.				
M.				
K.				
Mz.				
Me.				
V.				
S.				
S.				
A.				
R.				
Pe.				
G.				
T.D.				

SEP 19 '56
 FIRST REPORT

Date Comm. 9-14-56 Sohio FO
8" @ 200 w/125, Drlg. 2550 SEP 26 '56

Handwritten mark: a large 'Z' or '7' with a diagonal slash through it.

SEP 5 1956

R. G.

Co.
Lse.
No.
Sec.
T.
R.