


DX 78-1


Section 9 Township 32 Range 9W

Well No. #1 Coryell

Company Mull Drlg. Co.

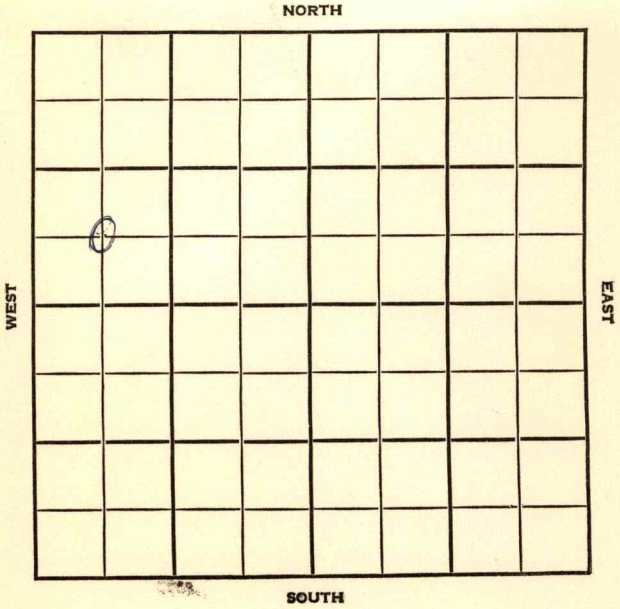

County Harper Elev. 1454  
 Sec. 9 Twp. 32 Rge. 9W  
 Company Mull Drlg. Co.  
 Farm Name Coryell No. 1

TOPS	DEPTH	LOG	DATUM	Loc. in Sec.
Anh.				C SW NW
Tp.				
H.				
Tr.				
Dg.				
Bl.				
L.		3578		Geol.
K.C.				Contr.
B.K.C.		3861		Co. Tools
Ce.				Pool
C.				Wildcat
M.	4312	4311		<div style="border: 1px solid black; padding: 5px; text-align: center;"> <b>ABANDONED</b>   </div>
M.				
K.				
Mz.				
Mo.				
V.				
S.				
S.				
A.				
R.				
PE.				
G.				
T.D.	4355			

Date Comm. spd. 11-10-56 Carter (AC & DHM)  
8" @ 120 w/ 100, Drlg. 1760 NOV 21 '56

① 4190 NOV 25 '56 X-DST 4314-33 1hr  
rel 95' 9SSY OCM + 100' HOCM FPO  
1BHP 1416 FBHP 210/20" DST  
4335-55 op 2 hrs 6/20" TSTM  
rel 45' OCM + 500' 9SSY oil + 50'  
MW FP PD-295 1BHP 1720 FBHP  
1280/20" RTD 4355 Rng 5 1/2" @ 4355  
1/150 DEC 5 '56 CO 100/4323-48

Mr \$ 1 1/2 Boph ~~1~~ wtr  
 Frac \$ 152 B0 + 77 BW  
 \$ 10 B0 + 200 BW no time  
 Dock SQ SQ w/cem. woc  
 DEC 12 '56 Co 36/4324-30 36/  
 4338-44 \$ 1/3 Boph Mr  
 \$ All wtr.

D E A

# WILDCAT

FORM 513 SUNRAY

County Harper Elev. \_\_\_\_\_  
Sec. 9 Twp. 32 Rge. 9W  
Company Mull Drlg. Co.  
Farm Name Coryell No. 1

TOPS	DEPTH	LOG	DATUM	Loc. in Sec.
Anh.				C SW NW
Tr.				
Dg.				
Bl.				
L.				Geol. _____
K.C.				Contr. _____
B.K.C.				Co. Tools
Ce.				Pool
C.				Wildcat
M.				<p>NOV 14 '56</p> <p>FIRST REPORT</p>
M.				
K.				
Mz.				
Me.				
V.				
S.				
S.				
A.				
R.				
Pe.				
G.				
T.D.				

Date Comm. spd. 11-10-56 Carter (AC & DHM)  
8" @ 120 w/ 100, Drlg. 1760

NOV 14 '56

*[Handwritten signature]*

*[Handwritten initials]*