


Section 18 Township 32 Range 9 W

Well No. #1 Hale

Company M. B. Armer

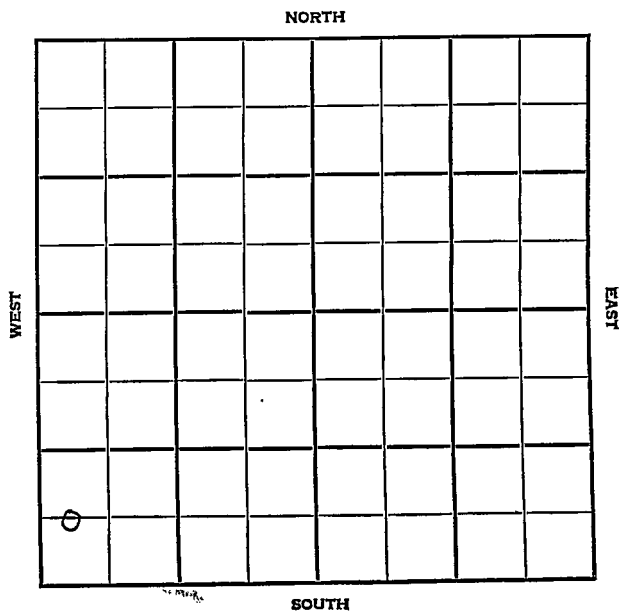

Harper

KANSAS

SEC.	TWP.	R.
18	32S	9W

WELL NO.

#1 Hale

FARM

COMPANY

M. B. Armer

CONTRACTOR

Sharon

Ft. from N. Line


660 Ft. from S. Line

Ft. from E. Line

330 Ft. from W. Line

NW SW SW CW/2 SW SW

BS W/2 SW/4 Mag. (FO)

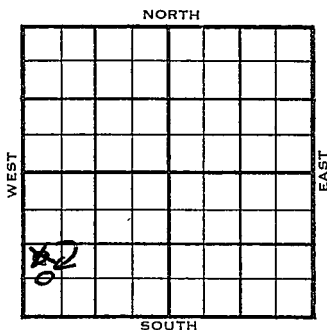

1955

ELEVATION

REPORT

4322 438'

7/20 Loc.

9/28

Comm 7-20-55

8 5/8" @ 230/150

Anh 1050

H 3383

Dg 3450

L 3602

M 4320

TD 4358

DST 4322-40 open 1 1/2 hr. Rec 30' mud

794/30" DST 4340-58 open 1 hr. gas

in 23 min. Rec 1943' oil 10' mud

90' SW 1686/30 DST 4354-58 open 1 hr

Rec 330' oil 30' wtr 50' hoem

5 1/2" @ 4358/300 GO to 4353 21/

4340-45 B/3 goph 1 hr 21/4345-50

B/60 goph 1 hr S 1 1/2 boph 4/4348-50

15/4350-52 S/6 boph 5 hr P/3 boph

Comp 170 bopd 12% wtr

COMPLETED

County Harper Elev. 1438
 Sec. 18 Twp. 32 Rge. 9W
 Company M. B. Armer
 Farm Name Hale No. 1

TOPS	DEPTH	LOG	DATUM	Loc. in Sec.
Anh.	1050			C W $\frac{1}{2}$ SWSW
Tr.				
H.	3383		1945	
Tr.				
Dg.	3450		2012	
Bl.				
L.	3602		2164	
K.C.				Geol.
B.K.C.				Contr.
Ce.				
C.				
M.	4320		2882	
M.				Pool
K.				Sharon
Mz.				
Mg.				
V.				
S.				
S.				
A.				
R.				
PE.				
G.				
T.D.	4358			

Date Comm. 7-20-55 SEP 28 1955
8 5/8" @ 230/150 DST 4322-40 open
1 $\frac{1}{2}$ hr. Rec. 30' mud 794/30"
DST 4340-58 open 1 hr. gas in 23 min.
Rec. 1943' oil 10' mud 90' sw 1686/30
DST 4354-58 open 1 hr. Rec. 330' oil
30' wtr. 50' hocm 5 $\frac{1}{2}$ " @ 4358/300
CO to 4353 21/ 4340-45 B/ 3 goph 1 hr.
21/ 4345-50 B/ 60 goph 1 hr.

OVER

S/ $1\frac{1}{2}$ boph 4/ 4348-50 15/ 4350-52
S/ 6 boph 5 hr. P/ 3 boph
Comp. 170 bopd 12% wtr.

_____	Misc.
_____	Pierce Map
_____	France Map
_____	Tracings
_____	Land Wall Map
_____	Land Small Map
_____	Scout Cards

W. W. W.

OCT 6 1955

County **Harper** Elev. _____
 Sec. **18** Twp. **32S** Rge. **9W**
 Company **M. B. Armer**
 Farm Name **Hale** No. **1**

TOPS	DEPTH	LOG	DATUM	Loc. in Sec.
Anh.				NW SW SW
Tr.				DS-W/2 SW/4
H.				Mag. (FO)
Tr.				Geol.
Dg.				Contr.
Bl.				
L.				
K.C.				
B.K.C.				
Ce.				
C.				
M.				
M.				
K.				
Mz.				
Mq.				
V.				
S.				
S.				
A.				
R.				
Pe.				
G.				
T.D.				

Pool **Sharon**

FIRST REPORT
JUL 20 1955

Date Comm. **Loc.**

Co.

Lse.

No.

Sec.

T.

R.

SCOUT TICKET

DX-201

Kansas

SEC.

TWP.

R.

18

32

9W

WELL NO.

1 Hale

FARM

COMPANY

M. B. Armer

CONTRACTOR

CORRECTION

C $W\frac{1}{2}$ SW SW

____ FT. FROM N. LINE


660

____ FT. FROM S. LINE

____ FT. FORM E. LINE

330

____ FT. FROM W. LINE

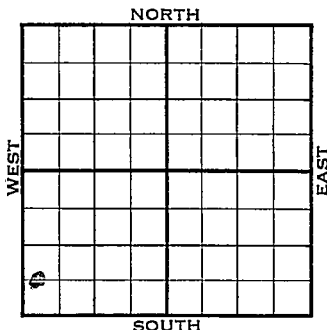

Harper County

☐

LOCATION

☐

RIG UP

DRILLING AND REMARKS:

Reported

NW SW SW

RECORD

CASED IN., FT.

SAND

GAS

OIL

TOTAL DEPTH

1ST 24 HRS. NAT.

1ST 24 HRS. AFTER SHOT

GAS CU. FT.

DRY HOLE

ABANDONED

PRODUCTION

DATE
AUG

3 1955

SCOUT

L. J. Harris