

2


32

9W

Section _____ Township _____ Range _____

Well No. #1 Dusenbury "B"

Company Iron Drlg. Co.

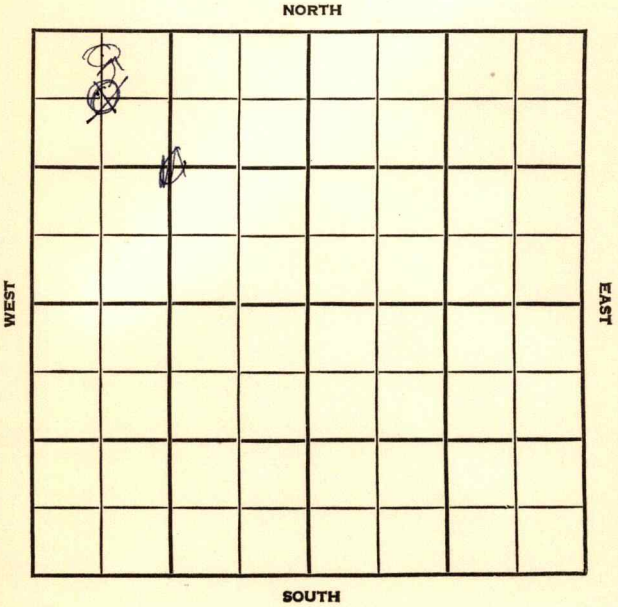

County Harper Elev. _____
 Sec. 2 Twp. 32 Rge. 9W
 Company Iron Drlg. Co.
 Farm Name Dusenbury "B" No. 1

TOPS	DEPTH	LOG	DATUM	Loc. in Sec.
Anh.				C NW NW
Tp.				
H.				
Tr.				
Dg.				
Bl.				
L.				Geol.
K.C.				Contr.
B.K.C.				
Ce.				
C.				
M.				Pool
M.				Spivey Grabs
K.				
Mz.				
Mq.				
V.				
S.				
S.				
A.				
R.				
PE.				
G.				
T.D.				



Date Comm. spd. 11-11-56 Carter (FO)

8" @ 195 w/135, Drlg. 995

NOV 14 1956

R.G.

CORRECTION

FORM 513 SUNRAY

County Harper Elev. 1518
 Sec. 2 Twp. 32 Rge. 9W
 Company Iron Drlg. Co.
 Farm Name Dusenbury "B" No. 1

TOPS	DEPTH	LOG	DATUM	Loc. in Sec.
Anh.				G NW NW
TP.				N2 NW NW
H.				43 OFWC
Tr.				660 FWC of sec
Dg.				Geol.
Bl.				Contr. 11011
L.				
K.C.				
B.K.C.				
Ce.				
C.				
M.	4327			
M.				Pool
K.				Spivey Grabs
Mz.				
Mo.				
V.				
S.				
S.				
A.				
R.				
PE.				
G.				
T.D.	4380			



Date Comm. spd. 11-11-56 Carter (FO)
 8" @ 195 w/135, Drlg. 995 NOV 21 '56 3739
 NOV 28 '56 DST 4329-40 1hr G/30"
 TSTM rec 124' U.S.O.C.W.M. FP
 30-42 BHP. 1505/20" DST
 4340-55 1hr rec 210' G.C.M.E
 30CM FP 60-95 BHP 895/20"
 DST 4355-80 1 1/2 hr. rec 60'
 O.S.G.C.M. + 60' SOC 9557 MW + 120'
 w/ no press recorded DCA