

Sumner

Section 12 Township 33 Range 1 ~~N~~ WWell No. # 1 Ray RuskCompany Herndon Drlg.

NORTH

3

			0				

SOUTH

WEST

EAST

Sumner


KANSAS

Sec. 12 Twp. 33 R. 1 WWell No. # 1 Ray Rusk FarmHerndon Drlg. CompanyHerndon Drlg. Contractor

Wildcat

990 Ft. from N. Line Ft. from S. Line330 Ft. from E. Line Ft. from W. Line

SE NE NW

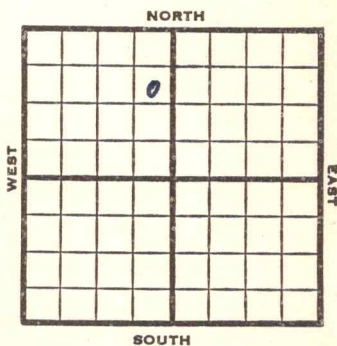

1953

Elev. 1209' REPORT

8/5 Location

8/12 8" @ 518' w/300 sks
Drlg 2562'

8/19 Drlg 4018'

8/26 Spud 8-5-53

D & A

TD 4275'

8" @ 518'

Lans 3145', Miss 3804',

DST 3804'-16 opn 2 hr, rec 260' mud
1198#

B. Miss. 4163', Chat 4224', Simp 4257'

TD 4275'

D & A

ABANDONED

County Sumner State KansasSec. 12 (Blk.
Twp.) 33 (Sur.
Rge.) 1W Map No.Operator Herndon Drlg.Well No. 1 Farm Ray RuskElev. 1209 Location SE NE NW990 Ft. From N Line NW330 Ft. From E Line Quarter

1st. Report

Completion AUG 26 1953Remarks WildcatHerndon Drlg. - Contr.Spudding Date 8-5-53Drlg. Data D & A TD 42758" @ 518 Lans. 3145 Miss. 3804DST 3804-16 open 2 hr. Rec. 260' mud1198# B. Miss. 4163 Chat. 4224Simp. 4257 TD 4275D & A