


Section 1 Township 33 Range 43 W

Well No. # 1 Glenn "A"

Company Cities Service

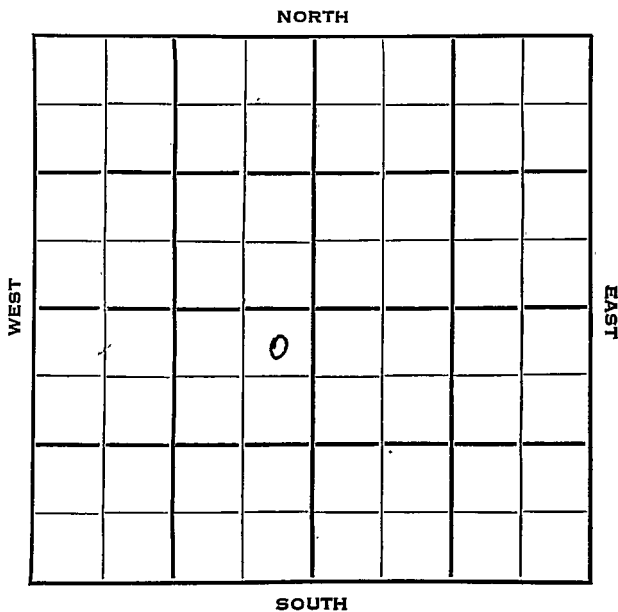

Morton KANSAS
33 43W

Sec. 1 Twp. _____ R. _____

Well No. #1 Glenn "A" Farm _____

Cities Service Company _____

Greenwood Gas Pool Contractor _____


330 Ft. from N. Line

_____ Ft. from S. Line

330 Ft. from E. Line

_____ Ft. from W. Line

NE NE SW

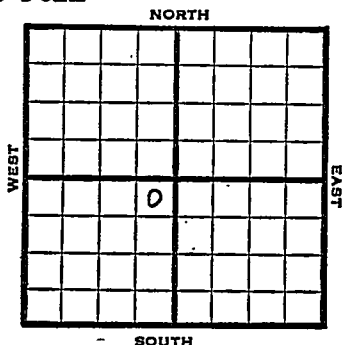

1953 Elev. 3574' REPORT

4/29 Location

5/7 8" @ 600
Drlg. 2300'

5/21 N.R.

5/28 Anhy 1380, Top 2921, Lans 3192'

6/3 N/R

6/10 NR

6/24 Spud 4-30-53

Gas Well

TD 3370

8" @ 600

TD 3370

5" @ 3364

CO to 3297

30/3286-92, 30/3264-70, 100/3238-58,

90/3200-18, 5000A

~~PEX#XXX~~ PB 3100

80/3072-88, 30/3056-62, 3000A, 6000A

DP 3297, PB 3034

20/3012-16, 25/2998-3003, 30/2987-93,

40/2967-75, 25/2952-57, 90/2922-40

4500A, 6000A, DP 3297, 6000A

Anhy 1380, Top 2921, Lans 3192

Comp. 27 mcfgpd 434#

3574	3570
2921	3192
+ 653	+ 382

COMPLETED

County Morton State Kansas

Sec. 1 (Blk.) 33 (Sur.) 43W Map No.

Operator Cities Service

Well No. 1 Farm Glenn "A"

Elev. 3574 Location NE NE SW

COMPLETE									

330Ft. From N Line SW

330Ft. From E Line Quarter

Ist. Report

Completion JUN 24 1953

Remarks Greenwood Gas Pool

Spudding Date 4-30-53

Drig. Data Gas well TD 3370

8" @ 600 TD 3370 5" @ 3364

CO to 3297 30/ 3286-92 30/ 3264-70

100/ 3238-58 90/ 3200-18 5000 A

PB 3100 80/ 3072-88 30/ 3056-62

3000 A 6000 A DP 3297 PB 3034

20/ 3012-16 25/ 2998-3003 30/ 2987-93

40/ 2967-75 25/ 2952-57 90/ 2922-40

4500 A 6000 A DP 3297 6000 A

Anhy 1380 Top. 2921 Lens. 3192

Comp. 27 mcf/gpd 434#

J. G. McGEHEE