KANSAS Stevens


FORM 51 5M 4-41 PETROL

Section 1 Township 33 Range 37-W

Well No. 1 Madden

Company Northern Natural Gas

Miscellaneous

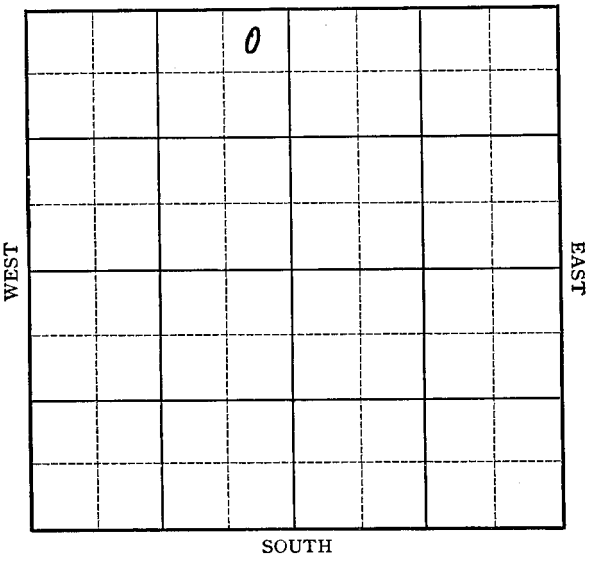

FORM 252-A 5M 6-41 PETROL

KANSAS

Stevens

Sec. 1 Twp. 33 R. 37-W

Well No. 1 Madden Farm

Northern Natural Gas Company


(Miscellaneous)

330 Ft. from N. Line

Ft. from S. Line

330 Ft. from E. Line

Ft. from W. Line

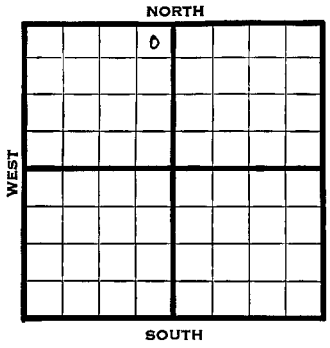

1941	REPORT
8/13	10" - 640'
	Drlg. 1250'
8/15	Dlg. 1250
8/21	" "
8/28	7" - 2632' T.D. 2821'
	3.6 M gas. 9000 acid.
9/4	" " " "
9/11	1000 acid. 30.2 M gas.
9/18	" " " "
9/25	" " " "
10/2	" " " "
10/8	[illegible]
	7" - 2632'
	T.D. 2821'
	10000 acid.
	35,913,000 cu. ft. gas.
	COMPLETED

Form 26 200 Bks. 5-41 McW.

Stevens KANSAS

Map No. N/11 Sec. 1 Twp. 33 R. 37W

Well No. 1 Madden

Northern Natural Gas Company

COMPLETED Contractor

NE NW


330 Ft. from N. Line

Ft. from S. Line

330 Ft. from E. Line

Ft. from W. Line

SECTION PLAT

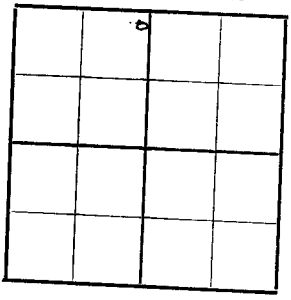

MISCELLANEOUS

Location

Rig up

Drilling and Remarks:

Trickel 2635.
7" @ 2632
1000 acid
35,913,000 cu ft
Gas

RECORD

Cased in., ft.

Sand

Gas

Oil

Total Depth 2821

PRODUCTION

1st 24 hrs. Nat.

1st 24 hrs. after shot

Gas Cu. Ft.

Dry Hole

Abandoned

Date

OCT 8 1941 19 S. J. LEWIS Scout

Form 26 2[illegible] KANSAS Stevens


Map No. NM Sec. 1 Twp. 33 R. 37W

Well No. 1 Madden

Northern Natural Gas Company

FIRST REPORT Contractor

SECTION PLAT

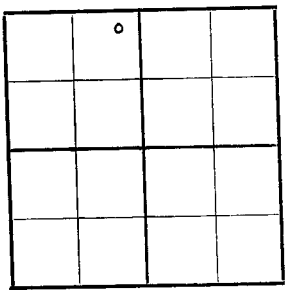

NE NW

330 Ft. from N. Line

Ft. from S. Line

330 Ft. from E. Line

Ft. from W. Line

MISCELLANEOUS

Location

Rig up

Drilling and Remarks:

10" - 640

Drlg. 1250

RECORD

Cased in., ft.

Sand

Gas

Oil

Total Depth

PRODUCTION

1st 24 hrs. Nat.

1st 24 hrs. after shot

Gas Cu. Ft.

Dry Hole

Abandoned

Date

AUG 13 1941 19

S. J. LEWIS Scout