


Section 1 Township 33 Range 37-W

Well No. #1 Swisher

Company Northern Natural Gas

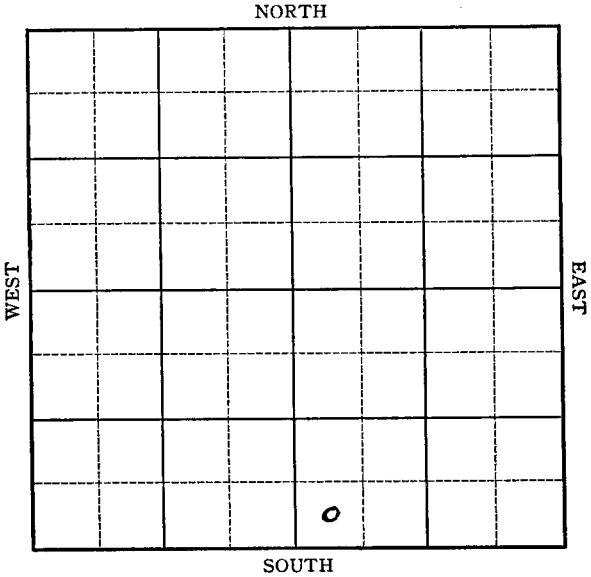

Sec. 1 Twp. 33 R. 37 -W

Well No. #1 Swisher Farm

Northern Natural Gas Company


(Misc.)

Ft. from N. Line

330 Ft. from S. Line

Ft. from E. Line

330 Ft. from W. Line

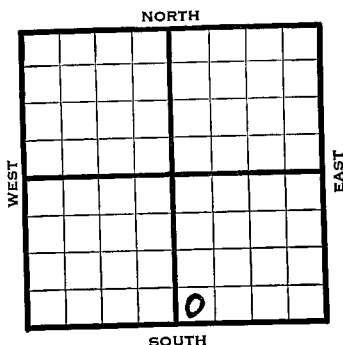

	REPORT
1941	
6/25	10" - 560'
	Drlg. 2530'
7/3	" "
7/10	Krider 2650' 7" - 2644'
	T.D. 2830' 2 $\frac{1}{4}$ M gas.
	10,000 acid.
7/17	" "
7/24	20 M gas
7/31	"
8/7	"
8/15	"
8/21	"
8/28	"
9/4	"
9/11	"
9/18	"
9/25	"
10/2	"
	OVER

1941
10/8

Krieger .A. Co.

7" - 2644'

T.D. 2830'

10,000 acid.

23,842,000 cu. ft. gas.

COMPLETED

Stevens

KANSAS

Map No. 111 Sec. 1 Twp. 33 R. 37WWell No. 1 SwisherNorthern Natural Gas CompanyCOMPLETED


Contractor

SW SE

 Ft. from N. Line330 Ft. from S. Line Ft. from E. Line330 Ft. from W. Line

MISCELLANEOUS

SECTION PLAT

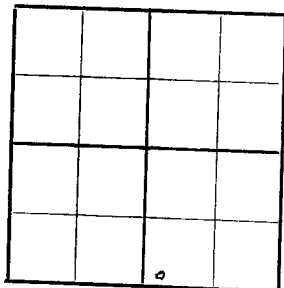Location Rig up

Drilling and Remarks:

*Kridler 2650**5" @ 2644**10000 cu ft**23,842,000 cu ft**Gas*

RECORD

Cased in., ft.Sand Gas Oil Total Depth 2880

PRODUCTION

1st 24 hrs. Nat. 1st 24 hrs. after shot Gas Cu. Ft.Dry Hole Abandoned

Date

OCT 8 1941

19

S. J. LEWIS

Scout

Stevens

KANSAS

Map No. 111 Sec. 1 Twp. 33 R. 37WWell No. 1 Swisher

Northern Natural Gas

Company

Contractor

FIRST REPORT

SW SE


Ft. from N. Line

330 Ft. from S. Line

Ft. from E. Line

330 Ft. from W. Line

SECTION PLAT

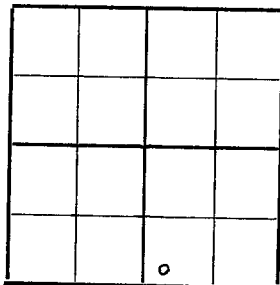

MISCELLANEOUS

RECORD

Location _____

Cased _____ in., _____ ft.

Rig up _____

Sand _____

Drilling and Remarks:

Gas _____

10" - 560

Oil _____

Total Depth _____

Dr1g. 2530

PRODUCTION

1st 24 hrs. Nat. _____

1st 24 hrs. after shot _____

Gas _____ Cu. Ft.

Dry Hole _____

Abandoned _____

Date

JUN 25 1941

19

S. J. LEWIS

Scout