DX 78-1

KANSAS


Stevens

Section 1 Township 33 Range 35W

Well No. 1 Mallory "A"

Company Northern Natural

6

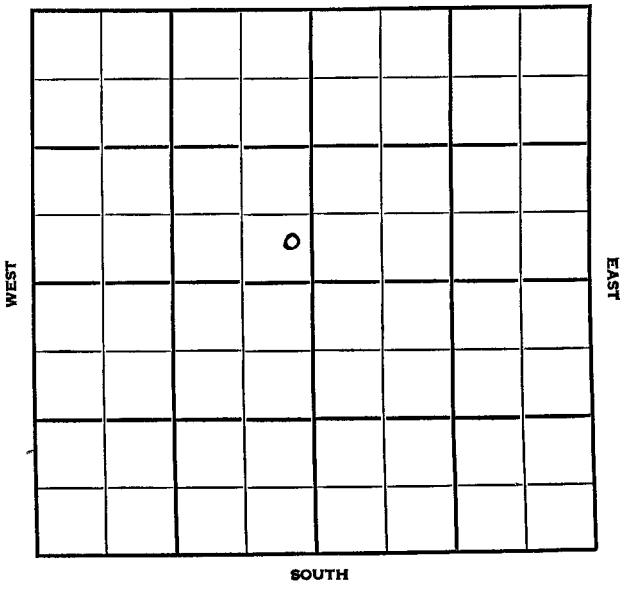

Stevens **KANSAS**

SEC.	TWP.	R.
1	33	35W

WELL NO.

#1 Mallory "A" FARM

COMPANY

Northern Natural

CONTRACTOR

Moran

Hugoton


_____ Ft. from N. Line

_____ Ft. from S. Line

_____ Ft. from E. Line

_____ Ft. from W. Line

SE SE NW

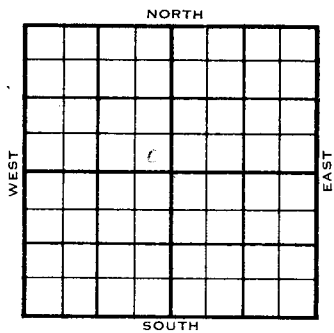

1955 ELEVATION	REPORT
7/6	Comm 5-8-55 10" @530/400 7" @2630/650 DD 2755 1000A frac DD 2761 1000A frac 4000A Comp. 10,734 mcfgpd 365# FIRST REPORT COMPLETED

X-78

FORM 513 REV. SUNRAY

County Stevens Elev.

Sec. 1 Twp. 33 Rge. 35W

Company Northern Natural

Farm Name Mallory "A" No. 1

TOPS	DEPTH	LOG	DATUM
Anh. Herr	2618	2618	
Tp. U. Krider		3047	
H. Krider		3075	
Tr. Foden		3711	
Dg. Wreford		2744	
B.L.			
L.			
K.C.			
B.K.C.			
Ce.			
C.			
M.			
M.			
K.			
Mz.			
Mo.			
V.			
S.			
S.			
A			
R.			
P€.			
G.			
T.D.	2761		

Loc. in Sec. SE SE NW

Geol.

Contr. Moran

Pool Hugoton

FIRST REPORT COMPLETE

JUL 6 1955

Date Comm. 5-3-55

10" @ 530/400 7" @ 2630/650

DD 2755 1000 A frac DD 2761

1000 A frac 4000 A

Comp. 10,734 mcfgpd 365#

Co. Lse. No. Sec. T. R.