


SECTION 1 TOWNSHIP 33 RANGE 31W

WELL NO. #1 Anthony "B"

COMPANY Shamrock

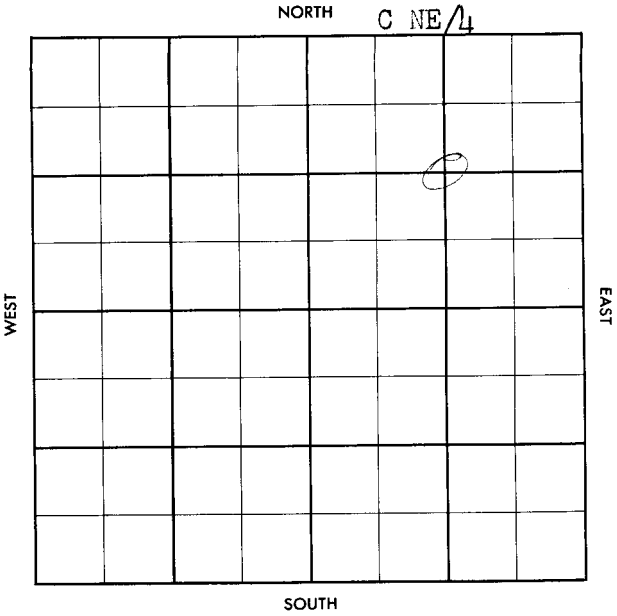


County Seward Elev. _____
 Sec. 1 Twp. 33 Rge. 31W
 Company Shawrock
 Farm Name Anthony WBN No. 1

TOPS	DEPTH	LOG	DATUM
Anh.			
TP.			
H.			
Tr.			
Dg.			
Bl.			
L.			
K.C.			
B.K.C.			
Ce.			
C.			
M.			
M.			
K.			
Mz.			
Me.			
V.			
S.			
S.			
A.			
R.			
PE.			
G.			
TD.			

Loc. in Sec. C NE/4

Geol. _____
 Contr. D & M Drlg.

Pool Stevens W

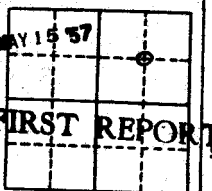

Date Comm. 5-12-57 United Prod. & Columbian Fuel
 Drlg. 1075 (FO)

~~3A~~

County Seward Elev. 2765
 Sec. 1 Temp. 33 Rgs. 31W
 Company Shanrock
 Farm Name Anthony "B" No. 1

TOPS	DEPTH	LOG	DATUM	Loc. in Sec.
Anh.				C NE/4
Tp.				
H.		4294		
To <u>date</u>	<u>2651</u>			
Dg.				
Bl.				
L.		4442		Geol.
K.C.				Contr.
B.K.C. <u>Marm</u>		5080		D & M Drlg.
Ce.		5249		
C. <u>47abd</u>		5265		Pool
M. <u>4wsh</u>		5578		
M. <u>chest</u>		5634		Stevens W
K.				
Mz.				
Me.				
V.				
S.				
S.				
A.				
R.				
PE.				
G.				
TD	<u>5690</u>			

Date Comm. 5-12-57 United Prod. & Columbian Fuel
 Drlg. 1075 MAY 22 57 Rng 9578 MAY 22 57 (FO)
9578 2673/470 3973
JUN 5 57 5325 57 CRD 5565
-5615 see 45' CRD 5615-40
see 25' DST 5580-5640 40
21" see 535' Md FP 210
BITP 2560/30" DST 5578-5640
47" see 120' Md NO SHOW
FP 140-140 BITP 200/30
NE 2