

Barber


DX 78-1

KANSAS

Section 6 Township 33 Range 10W

Well No. #1 Traffas

Company ~~R.C. Patton~~ MAGNOLIA.

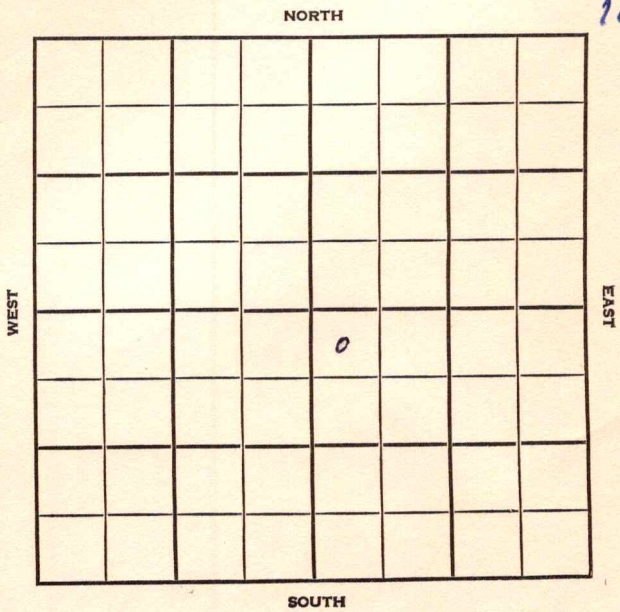

HOT FILE

Barber

KANSAS

SEC.	TWP.	R.
6	33	10W

WELL NO.

#1 Traffas

FARM

COMPANY

Magnolia Pet.
R.O. Patton

CONTRACTOR


Coppinger

330 Ft. from N. Line

Ft. from S. Line

Ft. from E. Line

330 Ft. from W. Line

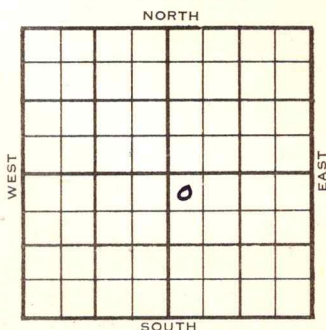

NW NW SE

Magnolia - F/O MCPC has SE $\frac{1}{4}$ of 5 & N $\frac{1}{2}$ NE $\frac{1}{4}$ of 8

	ELEVATION	REPORT
1955	1589'	
3/2	MIR	
3/10	Spud 3-3-55 8" @ 226' Drlg. 2400'	(Ltr-Gilstrap)
3/17	Doug 3767', Elgin 3528', Heeb. 3644' DST 3770-82', opn 1 hr., rec. 885' sgcsw, 1325# Lans. 3867' Drlg. 4265'	(Ltr-Gilstrap)
3/24	B KC 4381', Miss 4581' DST 4583-96', opn 1 hr., gas in 3", rec. 90' sgcm, 1508# DST 4596-4618', gas in 1 $\frac{1}{2}$ ", rec. 425, 000 cfg in 2 hrs., 110' sgcm, 1695# DST 4618-51', opn 1 $\frac{1}{2}$ hrs., rec. 60' mud 95# Kh. 4733', Viola 4855', Simp sd 4970' Drlg. 4975'	(Ltr-Gilstrap)
3/30	Arb. 5116' TD 5152' Set 5" @ 5134 WOC	(Ltr-Gilstrap)
4/7	CO to 5097' 48/ 4590-4604, B/ 40 gwph 5 hr. 416,000 cfg. B/ 7 go, 14 gswph 8 hr., viso-frac. F/L	(Ltr. Gilstrap)

OVER

1955

4/21

4/20

Completed for 1,262,000 CFGPD

Spud 3-3-55 SI Gas well TD 5152'

8" @ 226 Doug 3767' Elgin 3528'

Heeb 3644'

DST 3770-82 open 1 hr, rec 885' SGCSW

1325# Lans 3867' B KC 4381'

Miss 4581'

DST 4583-96, open 1 hr, gas in

3 min, rec 90' SGCM, 1508#

DST 4596-4618, gas in 1½ min,

425,000 CFG in 20 min. 490,000 CFG

2 hr. rec 110' SGCM, 1695#

DST 4618-51, open 1½ hr rec 60'

mud 95# Kh. 4733 Viola 4855

Simp. 4970' Arb. 5116' TD 5152'

5" @ 5134 Schl tops: Elgin 3526

Doug 3765', Lans 3871' B KC 4378'

Miss 4581' Kh. 4730' Viola 4879'

Simp. 4976 Arb. 5114' GO to 5097

48/4590-4604 B/40 GWPH 5 hr/

416,000 CFG B/7 GO 14 GSWPH 8 hr.

Viso-frac.

Comp. SI gas well 1,262,000 CFGPD

COMPLETED

SCOUT TICKET

DX-201

Kansas

SEC.

TWP.

R.

6

33

10W

WELL NO.

1 Traffas

FARM

COMPANY

Magnolia

CONTRACTOR

CORRECTION

NW NW SE

330

FT. FROM N. LINE


FT. FROM S. LINE

FT. FORM E. LINE

330

FT. FROM W. LINE

NORTH

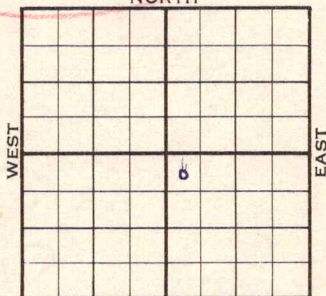

SOUTH

Barber County

☐

LOCATION

☐

RIG UP

DRILLING AND REMARKS:

Reported

R. C. Patton

RECORD

CASED IN., FT.

SAND

GAS

OIL

TOTAL DEPTH

PRODUCTION

1ST 24 HRS. NAT.

1ST 24 HRS. AFTER SHOT

GAS CU. FT.

DRY HOLE

ABANDONED

DATE

MAR 30 1955

SCOUT

FABEN GILSTRAP

County **Barber** State **Kansas**Sec. **6** (Blk.) **33** (Sur.) **10W** Map No.Operator **R. C. Patton**Well No. **1** Farm **Traffas**Elev. Location **NW NW SE****330** Ft. From **N** Line **SE****330** Ft. From **W** Line Quarter1st. Report **MAR 2 1955**

Completion

Remarks **Magnolia farmout****Patton - Contr.**

Spudding Date

Drig. Data **MCPG has SE $\frac{1}{4}$ of 5 & N $\frac{1}{4}$ NE $\frac{1}{4}$ of 8****M I R****FABEN GILSTRAP**

FABEN GILSTRAP

Drlg. Data

Viola 4879 Simp. 4976 Arb. 5114

CO to 5097 48/ 4590-4604 B/ 40 gwph

5 hr. 416,000 cfg B/ 7 go 14 gswph

8 hr. viso-frac

Comp. SI gas well 1,262,000 cfgcd

APR 26 1955

