


Section 10 Township 33 Range 10-W


Well Number #1 Palmer

Company Pure Oil

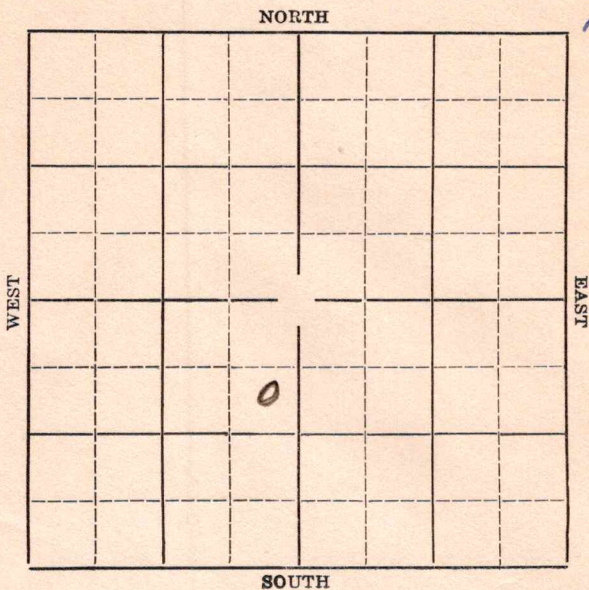

Sec. 10 Twp. 33 R. 10-WWell No. 1 Palmer FarmPure Oil Company990 Ft. from N. Line Ft. from S. Line330 Ft. from E. Line Ft. from W. Line

NORTH

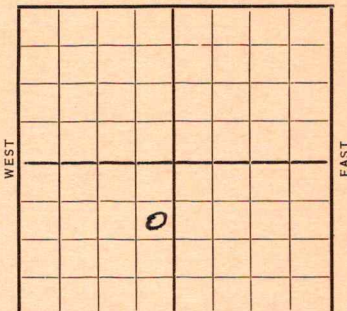

Elev. 1423

~~1936~~

REPORT

11/4

R. O. G.

11/12

Rig

11/19

13" @ 202 WOC

11/27

Drlg. 2000'.

12/3

Drlg. 2821'.

4872

12/10

Drlg. 3500'.

1423
3449

12/17

Kansas City 3818'.

Drlg. 4204'.

1937

1/6

Wilcox 4872'. Sil. 5010'.

T. D. 5061'. D & A.

COMPLETED

KANSAS

Map No. 61 Sec. 10 Twp. 33 R. 10WWell No. 1 PalmerPure Oil Company

Contractor

SECTION PLAT

980 Ft. from N. Line

_____ Ft. from S. Line

980 Ft. from E. Line

_____ Ft. from W. Line

FIRST REPORT

Location _____

Rig up _____

Drilling and Remarks:

ROG

RECORD

Cased _____ in., _____ ft.

Sand _____

Gas _____

Oil _____

Total Depth _____

PRODUCTION

1st 24 hrs. Nat. _____

1st 24 hrs. after shot _____

Gas _____ Cu. Ft.

Dry Hole _____

Abandoned _____

Date

NOV 4 1935 19

S. J. LEWIS Scout

KANSAS

Map No. 61 Sec. 10 Twp. 38 R. 10WWell No. 1 PalmerPure Oil Company

Contractor

SECTION PLAT

990 Ft. from N. Line

_____ Ft. from S. Line

830 Ft. from E. Line

_____ Ft. from W. Line

ABANDONED

Location _____

Rig up _____

Drilling and Remarks:

Witcox 4872Sil 5010D&H

RECORD

Cased _____ in., _____ ft.

Sand _____

Gas _____

Oil _____

Total Depth 5061

PRODUCTION

1st 24 hrs. Nat. _____

1st 24 hrs. after shot _____

Gas _____ Cu. Ft.

Dry Hole _____

Abandoned _____

Date

JAN 6 1937

19

S. J. LEWIS Scout