

Section 11 Township 33 Range 10WWell No. 1 GarnerCompany K & E Drlg., Mayfair Min., & SW Explr.

			0				

NORTH

WEST

EAST

SOUTH

3

SEC.	TWP.	R.
11	33	10W ✓

WELL NO.

1 Garner

FARM

COMPANY

K & E Drlg., Mayfair Min., & SW EXPLR.

CONTRACTOR

K & E Drlg.


Wildcat

330 Ft. from N. Line

Ft. from S. Line

330 Ft. from E. Line

Ft. from W. Line

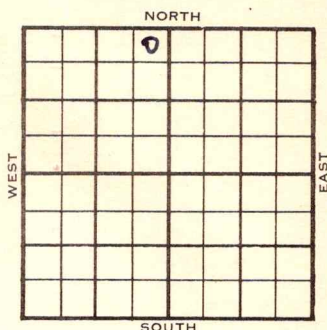

NE NE NW

Magnolia Farmout

1954

ELEVATION

1392'

REPORT

1/27

Spud 1-25-54
8" @ 199', WOC

2/3

Drlg 3220'

2/10

Elgin 3317',
DST 3315'-40' 1 hr, 8' M 1070#
Heeb 3434', Doug 3485'
DST 3470'-3500' 1 hr, 750' SW 1380#
Lay 3750',
DST 3746'-65' 1 hr, 1080' Wtr. 1390#
Drlg 4230'

2/17

Miss 4390'
DST 4388'-4400' 1 hr, no rec.
DST 4401'-21' 1 hr, 20' M 105#
DST 4422'-50' 1 hr, 765' SW 1680#
Kh 4580', Chat 4677', V 4716'
DST 4718'-35' 1 hr 15' M 150# Simp
4789'
Ø 4795'-4805' 10' C 4805'-15' 10'
DST 4803'-15' 1 hr, 1080' gas 90' o &
gcm 750' Wtr. 1853#

2/24

Spud 1-25-54
D & A
TD 4970'
8" @ 199'

OVER

1954

Information brought forward.

2/24

Elgin 3317'

DST 3315'-40' opn 1 hr, rec 8' Mud
1070# **Heeb 3434' Doug 3485'**

DST 3470'-3500' opn 1 hr, rec 750' sw
1380# **Layton 3750'**

DST 3746'-65' opn 1 hr, rec 1080' wtr.
1390# **Miss 4390',**

DST 4388'-4400' opn 1 hr, 960# no rec.

DST 4401'-21' opn 1 hr, rec 20' Mud
105#

DST 4422'-50' opn 1 hr, rec 765' SW
1680# **Kh. 4580', Chat 4677'**

Viola 4716'

DST 4718'-35' opn 1 hr, rec 15' Mud
150# **Simp 4789'**

DST 4803'-15' opn 1 hr, rec 1080' gas,
90' o & gcm 750' wtr. 1853#

DST 4924'-36' opn 1 hr, rec 15' Mud
1225# **Arb 4938'**

DST 4938'-70' opn $\frac{1}{2}$ hr, rec 488' sul
wtr. 1816#

TD 4970'

D & A

ABANDONED

County **Barber** State **Kansas**
 Sec. **11** (Blk. **33** (Sur. **10W** Map No.
 (Twp.) (Rge.)
 Operator **K & E Drlg., Mayfair Min., & SW Explo**
 Well No. **1** Farm **Garner**
 Elev. Location **NE NE NW**

0

FIRST REPORT

330 Ft. From **N** Line **NW**
330 Ft. From **E** Line Quarter

1st. Report **JAN. 27 1954**

Completion

Remarks **Magnolia farmout**
K & E Drlg. - Contr.

Spudding Date **1-25-54**

Drlg. Data

Wildcat

8" @ 199 WOC

J. G. McGEHEE

County Barber State Kansas
 Sec. 11 (Blk.) 33 (Sur.) 10W Map No.
 Operator K & E Drlg., Mayfair Min., & SW Ex.
 Well No. 1 Farm Garner
 Elev. 1392 Location NE NE NW



330 Ft. From N Line NW
330 Ft. From E Line Quarter

1st. Report

Completion FEB 24 1954

Remarks Wildcat

K & E Drlg. - Contr.

Spudding Date 1-25-54

Drlg. Data D & A TD 4970

8" @ 199 Elgin 3317 DST 3315-40

open 1 hr. Rec. 8' mud 1070#

Heeb. 3434 Doug. 3485 DST 3470-3500

open 1 hr. Rec. 750' sw 1380#

Layton 3750 DST 3746-65 open 1 hr.

Rec. 1080' wtr. 1390# Miss. 4390

DST 4388-4400 open 1 hr. 960# no'rec.

DST 4401-21 open 1 hr. Rec. 20' mud

105# DST 4422-50 open 1 hr. Rec.

765' sw 1680# Kh. 4580 Chat. 4677

Viola 4716 DST 4718-35 open 1 hr.

Rec. 15' mud 150# Simp. 4789

DST 4803-15 open 1 hr. Rec. 1080' gas

90' o & gcm 750' wtr. 1853#

J. G. McGEHEE

Drlg. Data

DST 4924-36 open 1 hr. Rec. 15' mud

1225# App. 4938 DST 4938-70 open $\frac{1}{2}$ hr.

Rec. 488' sul. wtr. 1816# TD 4970

D & A