


Section 36 Township 33 Range 10W

Well No. #1 D. F. Page

Company Ambassador

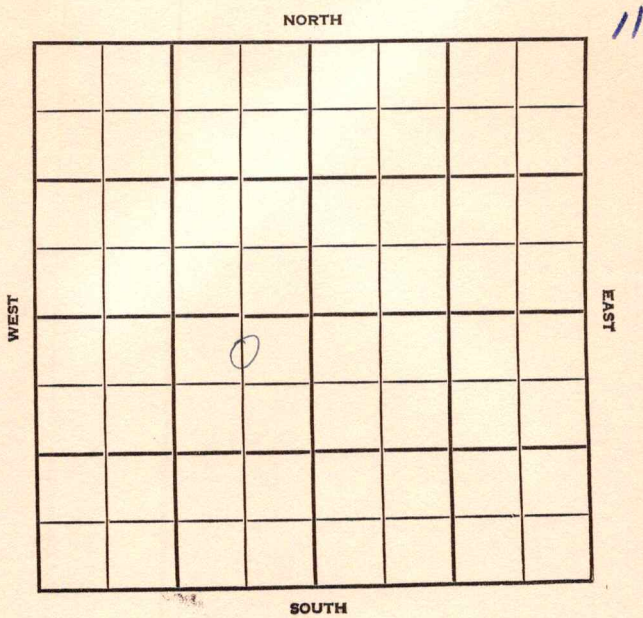

SEC. 36-	TWP. 33	R. 10W
-------------	------------	-----------


WELL NO. #1 D.F. Page FARM

COMPANY Ambassador

CONTRACTOR Peel Bros.

WILDCAT

_____ FT. FROM N. LINE
 _____ FT. FROM S. LINE
 _____ FT. FROM E. LINE
 _____ FT. FROM W. LINE

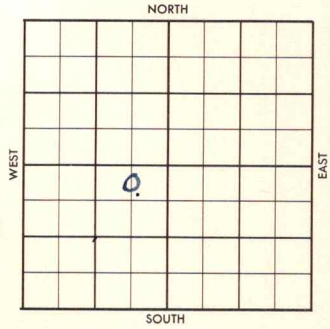

C N $\frac{1}{2}$ NE SW

1956	ELEVATION	REPORT
------	-----------	--------

7-11 Comm. 7-4-56
 8" @ 342
 Drlg. 3170

County Barber Elev. 1366 RB
 Sec. 36 Twp. 33 Rge. 10W
 Company Ambassador
 Farm Name D. T. Page No. 1

Co.

TOPS	DEPTH	LOG	DATUM
Anh. <u>Elgzn</u>	<u>3359</u>		
Tp. <u>Herr</u>		<u>1690</u>	
H. <u>Wfd</u>		<u>1751</u>	
Tr. <u>ET Rly</u>		<u>1818</u>	
Dg.	<u>3590</u>		
Bl.			
L.		<u>3944</u>	
K.C.	<u>4074</u>	<u>4083</u>	
B.K.C.	<u>4288</u>	<u>4293</u>	
Ce.			
C. <u>Marm</u>	<u>4358</u>	<u>4366</u>	
M. <u>ce</u>	<u>4495</u>	<u>4499</u>	
M.	<u>4548</u>	<u>4545</u>	
K.	<u>4760</u>	<u>4787</u>	
Mz. <u>chata</u>		<u>4871</u>	
Me.			
V.	<u>4901</u>	<u>4904</u>	
S.		<u>5000</u>	
S. <u>sd</u>		<u>5003-73</u>	
A.		<u>5168</u>	
R.			
PE.			
G.			
T.D.	<u>5215</u>	<u>5219</u>	

Loc. in Sec. C N¹ NE SW

Geol. _____
 Contr. Peel Bros.

Pool Wildcat

ABANDONED

OCT 10 1955

Loc.

No.

Sec.

T.

R.

Date Comm. 7-1-56
8" @ 312 drlc. 3170 JUL 10 55 # 4445
JUL 25 56 X DST 4540-^{44 69}~~65~~ hrs 1 hr
9 1/5" ga 380 MCF rec 125'
GCM BHP 1570 DST 45⁶⁶~~68~~-46⁰⁶~~08~~
hrs 1 hr 9 1/4" ga 90 MCF rec
200' Fluid (50CM To 140CM + Trace
Free oil in bottom of Tool) BHP
1640 # ~~4632~~ DST 4903-^{07 19}~~15~~ hrs
@ 125' GIP rec 54' 5 GCM + 60' SW
BHP 1900 # 4977 5 1/2 @ 4650/

36-33-10W

CN/7 no av

AUG 8 '56

① in Ad dops CO

96/4562-86 1/2 \$

3 ~~in~~ B0 + 67 BSW 12 hrs

testga 350 MCEG. S.D.

AUG 15 '56

S.D.

AUG 22 '56

AUG 29 '56

SEP 5 '56

SEP 12 '56

SEP 19 '56

SEP 26 '56

OCT 3 '56

OCT 10 '56

Temp abd

36-33-10W

CN/7 no av

1
27

County Barber Elev. _____
 Sec. 36 Twp. 33 Rge. LOW
 Company Ambassador
 Farm Name D. F. Page No. 1

Co.

TOPS	DEPTH	LOG	DATUM
Anh.			
Tr.			
H.			
Tr.			
Dg.			
Bl.			
L.			
K.C.			
B.K.C.			
Ce.			
C.			
M.			
M.			
K.			
Mz.			
Ma.			
V.			
S.			
S.			
A			
R.			
PE.			
G.			
T.D.			

Loc. in Sec. C N $\frac{1}{2}$ NE SW

Geol. _____
 Contr. Peel Bros.

Pool Wildcat

FIRST REPORT
 0
 JUL 11 '56

Lse.

No.

Sec.

T.

R.

Date Comm. 7-4-56
8" @ 342 drlg. 3170

THE END
 1000

WILDCAT O.W.W.O.

FORM 513 SUNRAY

County	Barber	Elev.	1366 RB
Sec.	36	Twp.	33
		Rge.	10W
Company	Ambassador Oil		
Farm Name	Page	No.	1

TOPS	DEPTH	LOG	DATUM	Loc. in Sec.
Anh.				C N/2 NE SW
TP.				
H.				(OWWO)
Tr.				
Dg.		3576		
BL.				
L.		3855		Geol.
K.C.		4083		Contr.
B.K.C.		4293		
Ce.		4499		
C.		4871		
M.		4366		Pool
M.		4545		Wildcat
K.		4787		
Mz.				
Mq.				
V.		4904		
S.		5000		
S.		5003		
A.		5168		
R.				
PE.				
G.				
T.D.		5219		

FIRST REPORT

NOV 7 '36

Date Comm. _____

Old Inf. Was D & A 5" @ 4650, New Info.

MICT Sqz all perms, to perf to hole.

2

Co. Lse. No. Sec. T. R.

County Barber Elev. 1366 RB
 Sec. 36 Twp. 33 Rge. LOW
 Company Ambassador Oil
 Farm Name Page No. 1

TOPS	DEPTH	LOG	DATUM
Anh.			
Tr.			
H.			
Tr.			
Dg.		3576	
Bl.		3855	
L.		4083	
K.C.		4293	
B.K.C.		4499	
Ce.		4871	
C.		4366	
M.		4545	
M.		4787	
K.			
Mz.			
Me.			
V.		4904	
S.		3000	
S.		5003	
A		5168	
R.			
PE.			
G.			
T.D.		5219	

Loc. in Sec. C N/2 NE SW
(OWWO)

Geol.

Contr.

Pool
Wildcat



Date Comm.

Old Inf. Was D & A 5" @ 4650, New Info.

MICT Sez all perms, to perf to hole. NOV 13 '56

SID NOV 21 '55 D&A hold NOV 28 '56

20/4562-66 1 1/2" & SW + 556

TSTM SGD CO 4560 40/4545

-55 1/2" & All water

D&A