

Section 29 Township 33 Range 10 W

Well No. " 1 Washburn

Company Jones, Shelburne & Farmer

NORTH

13

0							

WEST

EAST

SOUTH

SEC.	TWP.	R.
29	33	10W


WELL NO. #1 Washburn FARM

COMPANY Jones, Shelburne & Farmer

CONTRACTOR Co. Tools.

Wildcat.

_____ Ft. from N. Line
 330 _____ Ft. from S. Line
 _____ Ft. from E. Line
 330 _____ Ft. from W. Line

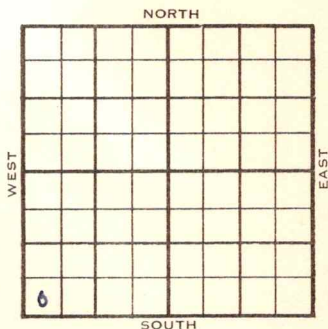

SW SW SW
 Pure- DHM

1954	ELEVATION	REPORT
	1470'	

112/22 Spud 12-16-54
 8" @ 255'
 Drlg. 2000'

1955
 2/2

Spud 12-16-54 D & A TD 5187
 8" @ 255 Heeb 3608 Tor. 3642
 Doug 3667 Stal. 3899 KC 4144
 B KC 4392 Miss. 4563
 DST 4567-76 open 1 hr gas in 4 min
 rec 55' mud. 1030#
 DST 4568-85 open 1 hr gas in 5 min,
 rec 90' GCM 1060#.
 DST 4586-4600 open 1 hr rec 50' SO &
 GCM 0#
 DST 4619-35 open 1 hr rec 60' VSOCM
 340# Kh. 4737 Chattanooga 4868'
 Viola 4910', Misener 4890', Maq. 4895'
 Simp. 4946 Arb. 5164'
 TD 5184 5" @ 4705
 Schl tops: Stal. 3906, KC 4146, B KC
 4396', Miss. 4567', Kh. 4760', Chatta-
 nooga 4868', Misener 4890', Maq. 4894',
 Viola 4900', Simp. 4999', Arb. 5161'
 TD 5187'. CO 80/4621-31 S/10 GW
 sd-frac. PB 4610 160/4576-96
 B/1 GO 13 GWPH 12 hr. sd-frac.
 S/7 1/2 BWPH D & A **ABANDONED**

County **Barber** State **Kansas**

Sec. **29** (Blk. Twp.) **33** (Sur. Rge.) **10W** Map No.

Operator **Jones, Shelburne & Farmer**

Well No. **1** Farm **Washburn**

Elev. Location **SW SW SW**

330 Ft. From **S** Line **SW**

330 Ft. From **W** Line Quarter

1st. Report **DEC 22 1954**

Completion

Remarks **Pure - DHM**

Co. tools

Spudding Date **12-16-54**

Drlg. Data **Wildcat**

8" @ 255 drlg. 2000

FABEN GILSTRAP

County Barber State Kansas

Sec. 29 (Blk.) 33 (Sur.) 10W Map No.

Operator Jones, Shelburne & Farmer

Well No. 1 Farm Washburn

Elev. 1470 Location SW SW SW

ABANDONED

330 Ft. From S Line SW

330 Ft. From W Line Quarter

1st. Report

Completion FEB 2 1955

Remarks Wildcat

Co. tools

Spudding Date 12-16-54

Drlg. Data D & A TD 5187

8" @ 255 Heeb. 3608 Tor. 3642

Doug. 3667 Stal. 3899 KC 4144

B KC 4392 Miss. 4563 DST 4567-76

open 1 hr. gas in 4 min. Rec. 55' mud

1030# DST 4568-85 open 1 hr. gas in

5 min. Rec. 90' gcm 1060#

DST 4586-4600 open 1 hr. Rec. 50' so &

gcm 0# DST 4619-35 open 1 hr.

Rec. 60' vsocm 340# Kh. 4737

Chattanooga 4868 Viola 4910 Misener 4890

Maq. 4895 Simp. 4946 Arb. 5164

TD 5184 5" @ 4705

FABEN GILSTRAP

Drlg. Data

SCHLUMBERGER TOPS:

Stal. 3906 KC 4146 B KC 4396

Miss. 4567 Kh. 4760 Chattanooga 4868

Misener 4890 Maq. 4894 Viola 4900

Simp. 4999 Arb. 5161 TD 5187

CO 80/ 4621-31 S/ 10 gw sd-frac

PB 4610 160/ 4576-96 B/ 1 go 13 gwph

12 hr. sd-frac S/ $7\frac{1}{2}$ bwph

D & A

FEB 2 1955

W. W.

