



Barber

Map No. **KANSAS** Sec. 12 Twp. 33 R. 10 W


Well No. 1 George Farm  
L. V. I. O. 58 Texas "4 Summit Oly Co. "8. Company

\_\_\_\_\_ Ft. from N. Line

660 Ft. from S. Line

660 Ft. from E. Line

\_\_\_\_\_ Ft. from W. Line

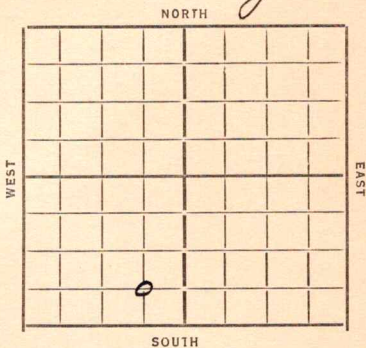

Date 1934

REPORT

|             |   |
|-------------|---|
| <u>6/27</u> | Location  |
| <u>7/5</u>  | Rog   |
| <u>7/12</u> | Ritgn   |
| <u>7/19</u> | Oly 1450  |
| <u>7/26</u> | " 2080  |
| <u>8/2</u>  | " 3450  |
| <u>8/9</u>  | Stalnicku 3705 Base 3835<br>Oly 4235                  |
| <u>8/16</u> | Whice L. 4394   |
| <u>8/23</u> | Grice L. 4394 - 4630<br>Viola 4702 S.S.O. 4703        |
| <u>8/29</u> | Simpson 4718 Vileot 4781<br>Silicow 4944 T 4982 D + A |

**ABANDONED**

*Backed*

Map No. 61 Sec. 12 Twp. 33 R. 10<sup>W</sup>

Well No. #1-George

ITI 0<sup>3</sup>/<sub>8</sub> Texas Co '14 Company

+ Summitt Reg Co '18 Int. Contractor

FIRST REPORTS

SECTION PLAT

|  |   |  |  |
|--|---|--|--|
|  |   |  |  |
|  |   |  |  |
|  |   |  |  |
|  | 0 |  |  |

\_\_\_\_\_ Ft. from N. Line

660 Ft. from S. Line

660 Ft. from E. Line

\_\_\_\_\_ Ft. from W. Line

Location ✓

Rig up \_\_\_\_\_

Drilling and Remarks:

RECORD

Cased \_\_\_\_\_ in., \_\_\_\_\_ ft.

Sand \_\_\_\_\_

Gas \_\_\_\_\_

Oil \_\_\_\_\_

Total Depth \_\_\_\_\_

PRODUCTION

1st 24 hrs. Nat. \_\_\_\_\_

1st 24 hrs. after shot \_\_\_\_\_

Gas \_\_\_\_\_ Cu. Ft.

Dry Hole \_\_\_\_\_

Abandoned \_\_\_\_\_

Date

6-27-34 19

ORVAL MANNSCHECK

Scout

KANSAS

Map No. 61 Sec. 12 Twp. 33 R. 10W

Well No. 1-George

ITI, Tex + Sumner Company

Contractor

ABANDONED

SECTION PLAT

|  |   |  |  |
|--|---|--|--|
|  |   |  |  |
|  |   |  |  |
|  |   |  |  |
|  | 0 |  |  |

\_\_\_\_\_ Ft. from N. Line

660 Ft. from S. Line

660 Ft. from E. Line

\_\_\_\_\_ Ft. from W. Line

Location \_\_\_\_\_

Rig up \_\_\_\_\_

Drilling and Remarks:

WTF

RECORD

Cased \_\_\_\_\_ in., \_\_\_\_\_ ft.

Sand silicious 4944

Gas \_\_\_\_\_

Oil \_\_\_\_\_

Total Depth 4982

PRODUCTION

1st 24 hrs. Nat. \_\_\_\_\_

1st 24 hrs. after shot \_\_\_\_\_

Gas \_\_\_\_\_ Cu. Ft.

Dry Hole \_\_\_\_\_

Abandoned \_\_\_\_\_

Date

8-29-34 19

ORVAL MANNSCHRECK

Scout