


Section 10 Township 33 Range 42W

Well No. #1 Wacker "B"

Company Cities Service

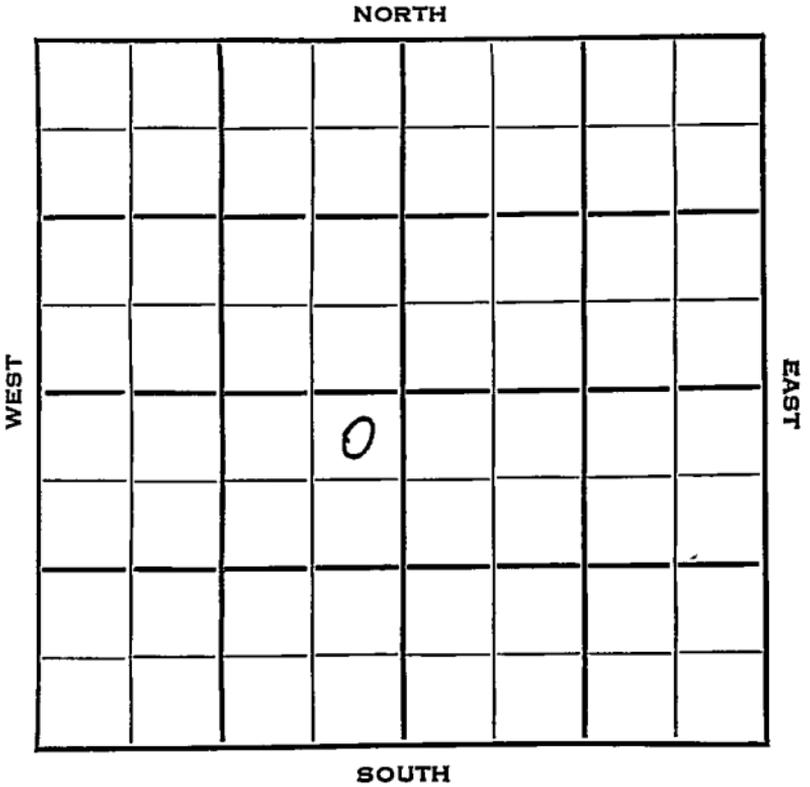

Sec. 10 Twp. 33 R. 42W

Well No. #1 Wacker "B" Farm

Cities Service. Company

Contractor


Greenwood Gas Pool

330 Ft. from N. Line

_____ Ft. from S. Line

330 Ft. from E. Line

_____ Ft. from W. Line

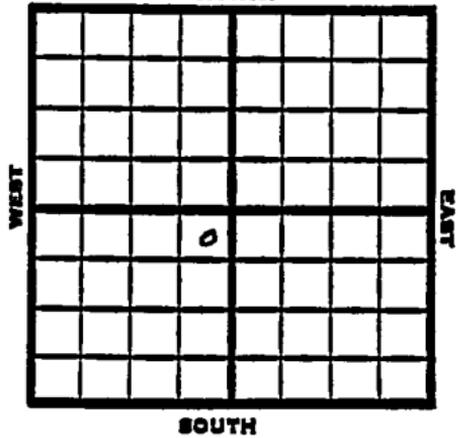

NE NE SW

1953 Elev. 3474' REPORT

7/2 Location
7/29 8" @ 600 w/300
Drlg. 2055'

8/5 RTD 3300
5" @ 3298'

8/12 N.R.

$$\begin{array}{r} 3474 \\ 2896 \\ \hline 578 \end{array}$$

$$\begin{array}{r} 3474 \\ 3148 \\ \hline +326 \end{array}$$

9/2 Spud 7-22-53
 Gas Well
 TD 3300'
 8" @ 600'
 Anhy 1344, Top 2896, Lans 3148
 TD 3300'
 5" @ 3298'
 CO to 3262 30. 3218-24 60/ 3178-90
 80/ 3152-68 5000 A 8,150,000 gas
 SP 3081 90/ 3040-58 40/ 3028-36
 4000 A 9,600,000 gas 4500A . CO to
 3262 15,800,000 gas SP 2991 20/
 2958-62 30/ 2936-42 20/ 2922-26
 50/ 2896-2906 4000 A 13,700,000 gas
 4500 A
 Comp. 26,600,000 gas 434#

COMPLETED

