


Morton

KANSAS

SECTION 10 TOWNSHIP 33 RANGE 42W

WELL NO. #1 Hentchel "B"

COMPANY Cities Service

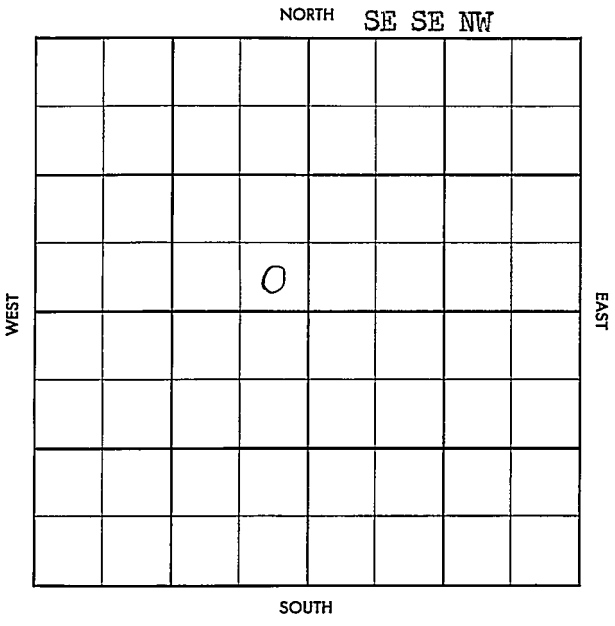

4948
3485
463

FORM 513 SUNRAY

Co.

County Morton Elev. 3485
 Sec. 10 Twp. 33 Rge. 42W
 Company Cities Service
 Farm Name Hentchel "B" No. 1

TOPS	DEPTH	LOG	DATUM
Anh.			
Ip.		2917	
H.		3238	
Tr.			
Dg.			
Bl.			
L.		3374	
K.C. <u>Marm</u>		3674	
B.K.C.			
Ce. <u>Mwsh</u>		4403	
C. " <u>sd</u>		4524-44	
M. " <u>sd</u>		4752-84	
M.			
K. <u>Keyes</u>		4856	
Mz.			
Mo. <u>chest</u>		4948	
V. <u>st Gen.</u>		5072	
S.			
S.			
A.			
R.			
PE.			
G.			
TD.	<u>5085</u>		

Loc. in Sec. SE SE NW
deep test
 Geol. _____
 Contr. _____
 Pool Greenwood

COMPLETE
 0.
 APR 3 '57

Lse.

No.

Sec.

T.

R.

Date Comm. 2-8-57

8" @ 1368/600 FEB. 57 IP 3535' 160' 51'
 DST 4520-39 1hr 660' GIP
 nec 20' Md FP 0 BHP 240
 1/5" DST 4750-98 30" 30'
 Md BHP 0/18" DST (Keyes) 4843
 -93 1hr 6/3" ga 1,250 MCF
 1/5" stab 1 @ 2,160/45" nec
 350' M&S SW 5 1/2 5084/400
 CO 1/3" 57 606910 50/4858-68, 6,570 MCF

500 MCA 3 440 MCF
 Frae 9,040 MCF / 24
 SIP 833⁰ APR 27 '57 ga 6,424 MCF
 10 10 hrs ga 8,840 MCFW
 APR 3 '57 cal op F/W 11
 Mill CGLD SIP 830#

County Morton Elev. _____
 Sec. 10 Twp. 33 Rge. 42W
 Company Cities Service
 FarmName Hentchel "B" No. 1

TOPS	DEPTH	LOG	DATUM
Anb.			
Tr.			
H.			
Tr.			
Dg.			
Bl.			
L.			
K.C.			
B.K.C.			
Ce.			
C.			
M.			
M.			
K.			
Mz.			
Me.			
V.			
S.			
S.			
A.			
R.			
PE.			
G.			
T.D.			

Loc. in Sec. _____
SE SE NW
deep test
 Geol. _____
 Contr. _____
 Pool
Greenwood

FIRST REPORT	
0	
FEB 19 '57	

Date Comm. 2-8-57
8" @ 1368/600

Handwritten signature/initials

Co.
Lse.
No.
Sec.
T.
R.