


Section 10 Township 33 Range 40W
 Well No. #1 Hayward
 Company Panhandle Eastern

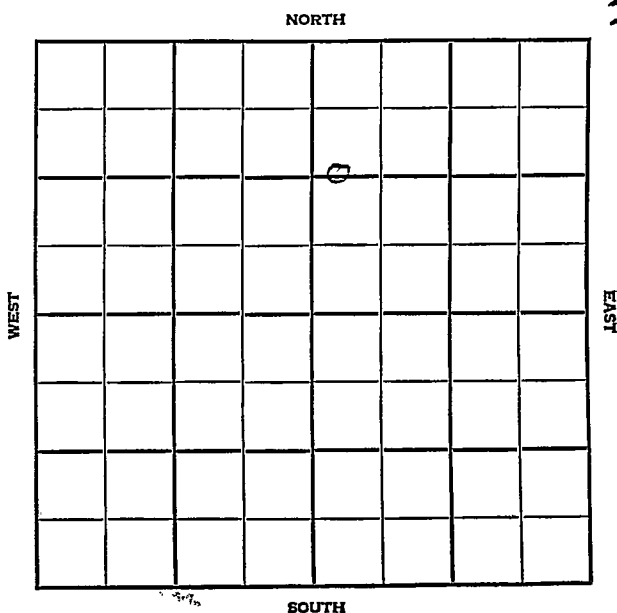

Morton

KANSAS

SEC.	TWP.	R.
10	33	40W

WELL NO.

#1. Hayward

FARM

COMPANY

Panhandle Eastern

CONTRACTOR

Kuhn Drlg.


_____ Ft. from N. Line

_____ Ft. from S. Line

_____ Ft. from E. Line

_____ Ft. from W. Line

C W $\frac{1}{2}$ W $\frac{1}{2}$ NE 1320' NL
2290' EL

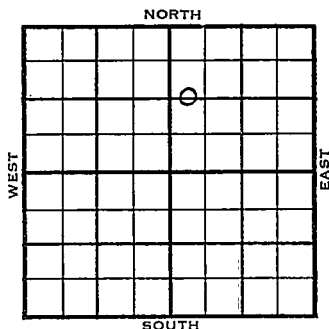

1955

ELEVATION

3279

REPORT

6/8

Comm 5-1-55

8 5/8" @512/275 5 1/2" @2492-125 CO

24/2434-40 16/2428-32 12/2420-23

4000 A sq. Co 32/2405-13, 1000A

656 mcfg 3000 A 5,400 mcfg 16/2386-90

32/2376-84 16/2372-76 16/2386-90

12/2354-57 12/2349-52 20/2328-33

64/2308-24 20/2296-2301 12/2290-93

Tops.

Log

H. Herr

2247

Tr. Kri.

2278

Dg. Winf.

2349

Bl. Tow.

2404

TD.

2500

16/2282-86 2000Q 8,150 mcfg, 10,812
mcfg. 18000 A DP 2500 SI 12 hr. 13,572
mcfg.

Comp? 17,758 mcfgpd 398#

FIRST REPORT

+

COMPLETED

County Morton ✓ Elev. 3279Sec. 10 Twp. 33 Rgs. 40WCompany Panhandle EasternFarm Name Hayward No. 1

TOPS	DEPTH	LOG	DATUM	Loc. in Sec.
Anh.				C W $\frac{1}{2}$ W $\frac{1}{2}$ NE
Tr.				1320' NL
H. <u>Herr</u>		<u>2247</u>		2290' EL
Tr. <u>Kri</u>		<u>2278</u>		
Dg. <u>Winf</u>		<u>2349</u>		
Bl. <u>Tow</u>		<u>2404</u>		
L.				Geol.
K.C.				Contr.
B.K.C.				Kuhn Drlg.
Ce.				Pool
C.				Hugoton
M.				
M.				
K.				
Mz.				
Mq.				
V.				
S.				
S.				
A.				
R.				
PE.				
G.				
T.D.	<u>2500</u>			

FIRST REPORT
COMPLETE

Date Comm. 5-1-55

JUN 8 1955

8 5/8" @ 512/275 5 1/2" @ 2492-125 CO

24/ 2434-40 16/ 2428-32 12/ 2420-23

4000 A sq. CO 32/ 2405-13 1000 A

656 mcfg 3000 A 5,400 mcfg SP 2402

16/ 2395-99 5,400 mcfg 16/ 2386-90

32/ 2376-84 16/ 2372-76 16/ 2362-66

12/ 2354-57 12/ 2349-52 20/ 2328-33

64/ 2308-24 20/ 2296-2301 12/ 2290-93

16/ 2282-86 2000 A 8,150 mcfg

10,812 mcfg 18000 A DP 2500

SI 12 hr. 13,572 mcfg

Comp. 17,758 mcfgpd 398#

Scout Cards	✓
Land Small Map	
Land Wall Map	
Tracings	
France Map	
Pierce Map	
Misc.	