


Map No. KANSAS Sec. 10 Twp. 33 R. 39th
 Well No. 2. Christopher Farm

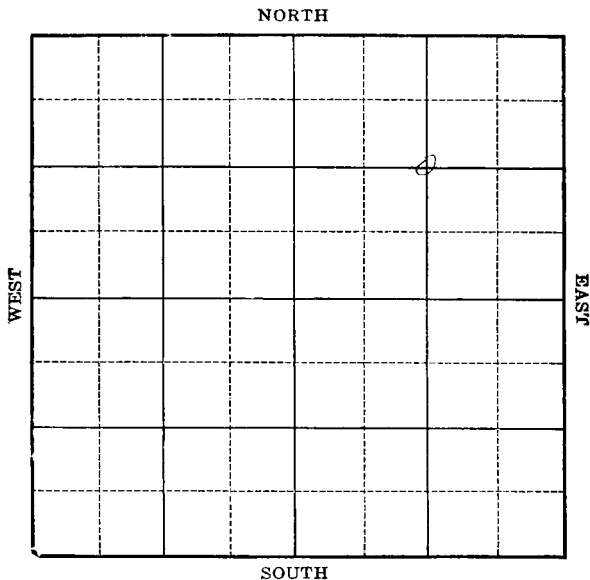

Location _____
 Drilling Remarks _____

Rig Up _____
 Drilling Remarks _____

RECORD


Cased _____ in. _____ ft.
 Sand _____
 Gas _____
 Oil _____
 Total Depth _____

PRODUCTION

1st 24 hrs. Nat. _____
 1st 24 hrs. after shot _____
 Gas _____ cu. ft.
 Dry Hole _____
 Abandoned _____

Map No. KANSAS Sec. 10 Twp. 33 R. 39
 Well No. 2-Christopher Farm
Argus Gas Company

NORTH

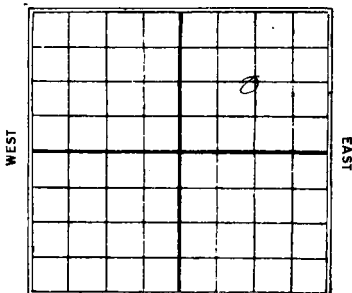

1320 Ft. from N. Line

_____ Ft. from S. Line

1320 Ft. from E. Line

_____ Ft. from W. Line

1930

Date

REPORT

8/13	Loc
7/20	
7/27	Rig
8/3	Rig up
9/10	Orly 480'
7/17	" 2060'
9/24	" 2350'
10/1	No report
10/8	Orly 2652'
10/22	Orly 2780'
1/29	
1/5	
1/12	
1/19	Set 10"-2910'
1/25	Orly 2975'
2/3	" 3306'
2/10	" 3736'
2/17	" 4130'
2/23	" 4133'
2/30	Set 8"-4238'
	(over)

10/31

1/17- T.D. 4238' Rust

1/14- Refused to give any
information until
wcc is constituted

1/21- drlg 4318'

1/28- " 4500'

2/4- " 4600'

2/11- " 4717

2/18- " 4765

2/25- No report

3/4- drlg 4845'

3/11- " 4900'

3/18- " 4980'

3/25- " 5100'

4/1- No report

4/8- drlg 5115'

4/15- No report

4/22- drlg 5260'

4/29- " 5295'

5/6- " 5420'

5/13 —

5/20 —

5/27 —

6/3- No report

6/10 —

6/17 —

6/24- SD 5521

7/1- T.D. 5521

Temp abandoned

Map No. KANSAS Sec. 10 Twp. 33 R. 35N

Well No. 2 Christopher

Argus Gas Company

Contract

SECTION PLAT

1820 Ft. from N. Line

_____ Ft. from S. Line

1820 Ft. from E. Line

_____ Ft. from W. Line

FIRST REPORTS

Location ✓

RECORD

Cased _____ in., _____ ft

Sand _____

Gas _____

Oil _____

Total Depth _____

PRODUCTION

1st 24 hrs. Nat. _____

1st 24 hrs. after shot _____

Gas _____ Cu. Ft.

Dry Hole _____

Abandoned _____

Drilling and Remarks:

Date

AUG 1 1930

19

Scout

*Stevens*Map No. _____ Sec. *10* Twp. *33* R. *39*^WWell No. *2 Christopher**Argus Gas Co.* Company_____
Contractor

COMPLETE

SECTION PLAT


1320 Ft. from N. Line

_____ Ft. from S. Line

1320 Ft. from E. Line

_____ Ft. from W. Line

ABANDONED

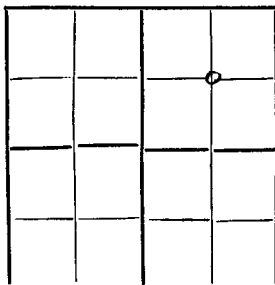

Location _____

Rig up _____

Drilling and Remarks:

Temp Abandoned
at 5521

RECORD

Cased _____ in., _____ ft.

Sand _____

Gas _____

Oil _____

Total Depth *5521*

PRODUCTION

1st 24 hrs. Nat. _____

1st 24 hrs. after shot _____

Gas _____ Cu. Ft.

Dry Hole _____

Abandoned *Temp*

Date

JUL 1 1931

CHAS. L. SHERWOOD

192

Scout