
Stevens

FORM 51 5M PETROL

Section 10 Township 33 Range 37W

Well No. 1 Crawford est.

Company Republic Nat.

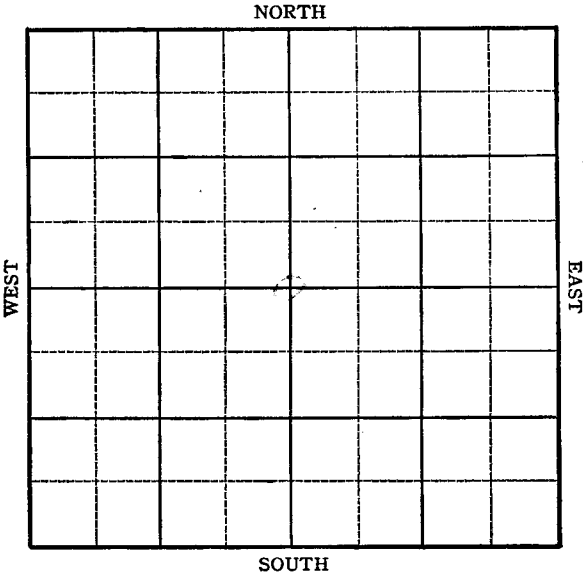

FORM 252-A
5M 8-45 PETROL

KANSAS Stevens

Sec. 10 Twp. 33 R. 37-W

Well No. #1 Crawford est. Farm


Republic Nat. Company

2640 Ft. from N. Line

Ft. from S. Line

2640 Ft. from E. Line

Ft. from W. Line

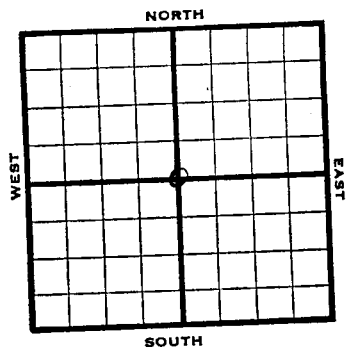

C Sec.

1945	REPORT Elev. 3103
10/17	RUR
10/24	10" @ 602 TD 2539' Run 7"
10/31	7" @ 2539 RUST
11/7	TD 2800 289' of 5" Perf. liner @ 2800
11/14	" " " " "
~~XX/XXXX~~	~~10"XXXXXX~~ ~~XXXXXXXXX~~ ~~XXXXXXXXXXXXX~~
11/21	TD 2800' 289' of 5" Perf. liner @ 2800
11/28	12500 acid.
12/5	" "
12/12	" "
12/20	" "
12/29	" "
1946	
1/9	7" @ 2539 289' of 5" perf. liner @ 2800 12,500 acid. TD 2800 17,673,000 Gas. 391# R Pr.

COMPLETED

FORM 26 200 BKS 1-44 PETROL

Kansas Pool Name Hugoton

Map No. Sec. 10 Twp. 33 R. 37W

Well No. 1 Crawford est.


Republic Nat. Company

FIRST REPORT

Contractor

C sec..

SECTION PLAT

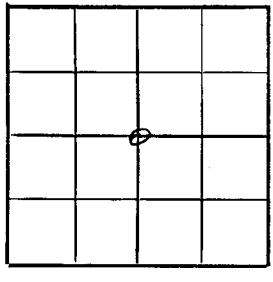

2640 Ft. from N. Line

Ft. from S. Line

2640 Ft. from E. Line

Ft. from W. Line

Stevens County

Location

Rig up

Drilling and Remarks:

RUR.

RECORD

Cased in., ft.

Sand

Gas

Oil

Total Depth

PRODUCTION

1st 24 hrs. Nat.

1st 24 hrs. after shot.

Gas Cu. Ft.

Dry Hole

Abandoned

Date

OCT 17 1945 19 S. J. LEWIS Scout

FORM 26 200 BKS. 2-44 PETROL

KANSAS Kansas Pool Name Hugoton

Map No. (illegible) Sec. 10 Twp. 33 R. 37W


Well No. 1 Crawford Est.

Republic Nat. Company

COMPLETED Contractor

C Sec. E/3/02

SECTION PLAT

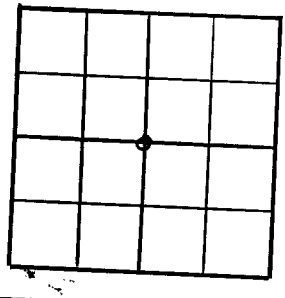

2640 Ft. from N. Line

Ft. from S. Line

2640 Ft. from E. Line

Ft. from W. Line

Stevens County

Location

Rig up

Drilling and Remarks:

9" @ 245'

2891' 3" @ 2891' Liner

@ 1800

1250 acid

12,478,000 Gas

2891' & Pkr

RECORD

Cased in, ft.

Sand

Gas

Oil

Total Depth 2880

PRODUCTION

1st 24 hrs. Nat.

1st 24 hrs. after shot.

Gas Cu. Ft.

Dry Hole

Abandoned

Date

JAN 9 1946 19

S. J. LEWIS Scout