


Well No. #1 Hitch

Company Panhandle Eastern

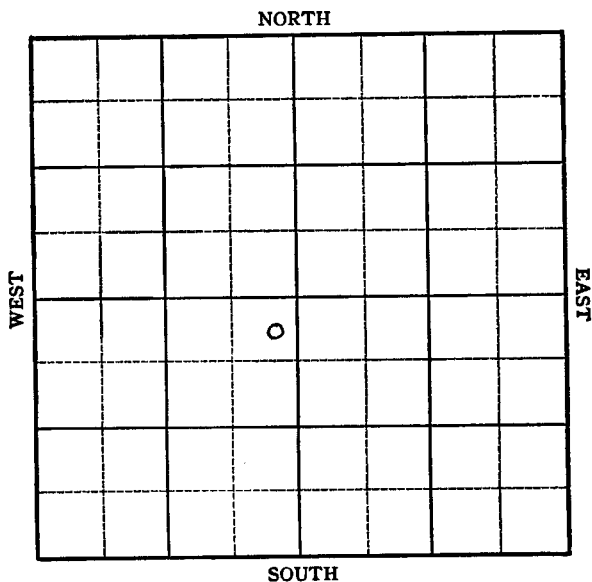

Sec. 10 Twp. 33 R. 34W

Well No. #1 Hitch Farm _____

Panhandle Eastern

Company _____

Hugoton Pool


374' Ft. from N. Line

_____ Ft. from S. Line

100' Ft. from E. Line

_____ Ft. from W. Line

NE SW

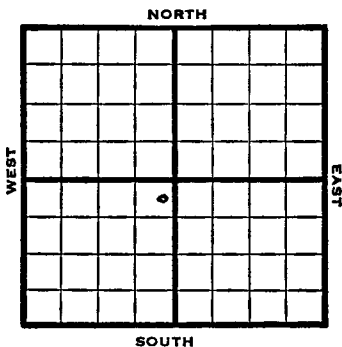

1949 Elev 2897' REPORT

9/14 9/21 9/28 10/5 10/12 10/19 10/26 1/2	Location " " 10" @ 498' Drlg 2360' TD 2580' 7" @ 2564' " 159' of 5" Perf liner @ 2709 TD Acid 13,000 TD 2709' 7" @ 2564' 159' of 5" Perf Liner @ 2709' 13000 acid 20,356,000 Gas 419# R Pr. Comp COMPLETED
--	--

Kansas

Hugoton Pool

Map No. _____ Sec. 10 Twp. 33 R. 34WWell No. 1 Hitch

_____ Panhandle Eastern _____ Company

_____ Moran _____ Contractor

NE SW

SECTION PLAT

374 Ft. from N. Line

_____ Ft. from S. Line

100 Ft. from E. Line

_____ Ft. from W. Line

	a		

Seward County

Location X

Rig up _____

Drilling and Remarks:

RECORD

Cased _____ in., _____ ft.

Sand _____

Gas _____

Oil _____

Total Depth _____

PRODUCTION

1st 24 hrs. Nat. _____

1st 24 hrs. after shot _____

Gas _____ Cu. Ft.

Dry Hole _____

Abandoned _____

Date

SEP 14 1949

19

S. J. LEWIS Scout

Map No. _____ Sec. 10 Twp. 33 R. 34W

Well No. 1 Hitch

Panhandle Eastern Company

COMPLETE Contractor

NE SW


E. 2579
SECTION PLAT

374 Ft. from N. Line

_____ Ft. from S. Line

100 Ft. from E. Line

_____ Ft. from W. Line

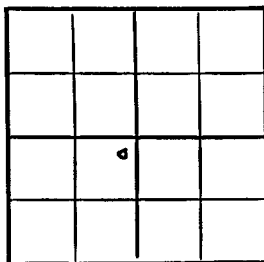

Seward County

RECORD

Location _____

Cased _____ in., _____ ft.

Rig up _____

Sand _____

Drilling and Remarks:

Gas _____

7" C2564

Oil _____

159' x 15" Prof. hole

Total Depth *2709*

C2709

PRODUCTION

18000 acid

1st 24 hrs. Nat. _____

20,358,000 cu.

1st 24 hrs. after shot _____

Gas _____ Cu. Ft.

Dry Hole _____

Abandoned _____

Date

NOV 2 1949 19

S. J. LEWIS Scout