

34-38-11W


WELL LOG BUREAU—KANSAS GEOLOGICAL SOCIETY
508 East Murdock, Wichita, Kansas

Company- JONES-GEBERT OIL CO.
Farm- Forester No. 1

SEC. 34 T. 33 R. 11W
C SW NW

Total Depth. 4545'
Comm. 1-3-63 Comp. 1-14-63
Shot or Treated.
Contractor.
Issued. 5-4-63

County Barber
KANSAS

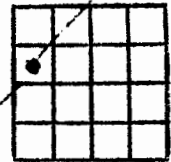

CASING:
8 5/8" 233' cem w/175 sx.

Elevation. 1366' KB

Production. DRY


Figures indicate Bottom of Formations.

red bed	233
shale red bed	650
shale & shells	1300
lime & shale	1865
lime	2015
lime & shale	2185
lime	2300
lime & shale	2550
shale & lime	2780
lime & shale	2955
shale & lime	3810
lime	3980
lime & shale	4110
lime	4215
lime & shale	4280
lime	4385
lime & shale	4505
lime	4545
Total Depth	

TOPS: LOG	
Heebner	3556
Douglas	3586
Lansing	3760
Base Kansas City	4294
Reworked Mississippi	4467
Mississippi	4481

SW NW
34-33-11

34-33-11W

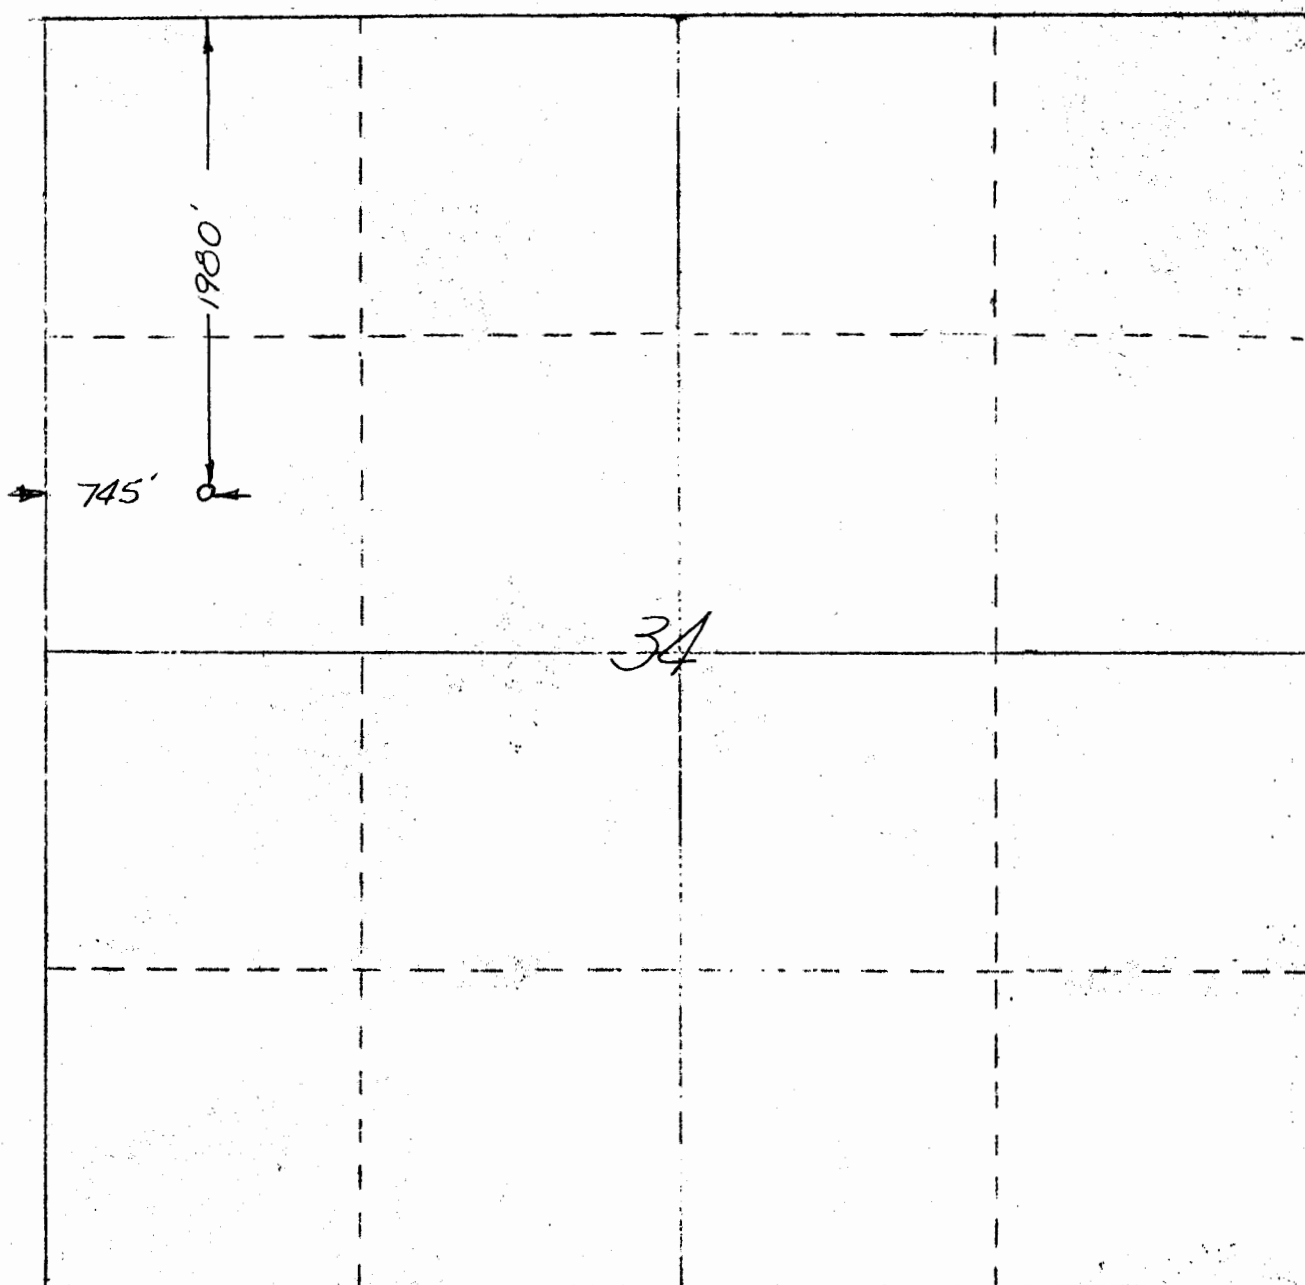

LOCATION in the center of the SW $\frac{1}{4}$ of the NW $\frac{1}{4}$ of Section 34,
Township 33S, Range 11W
Location moved 85 feet east to edge of stream

STAKED BY

Leroy E Willis
LEROY E WILLIS
COUNTY ENGINEER

DATE STAKED December 22, 1962

STAKED FOR Jones- Gebert Oil Inc
Central Building
Wichita 2, Kansas