


Section 20 Township 33 Range 11W

Well No. 1 W. A. Newkirk

Company XVI Continental Oil

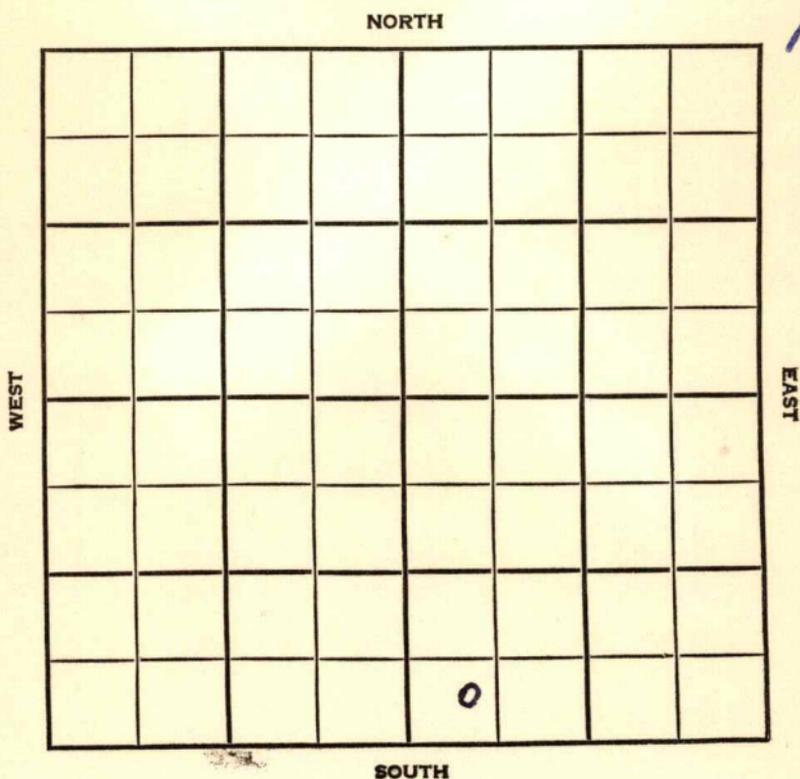

Barber

KANSAS

SEC.	TWP.	R.
20	33	11 W

WELL NO. # 1 W. A. Newkirk FARM

COMPANY Continental Oil


CONTRACTOR Anschutz
Gerlene Pool

_____ Ft. from N. Line

440 _____ Ft. from S. Line

2200 _____ Ft. from E. Line

_____ Ft. from W. Line

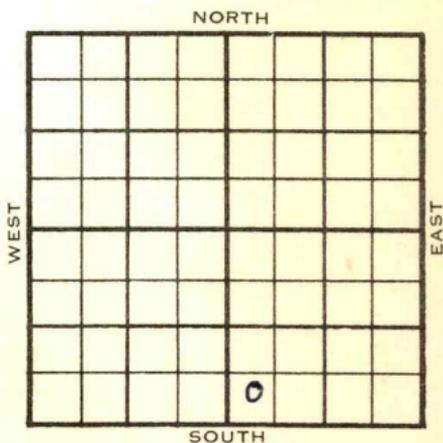

SW SW SE

	ELEVATION	REPORT
1954	1377'	

8/25 Miss. Test 4600'

Cellar & Pits

10/20 Spud 8-25-54 Oil well TD 4538
 8-5/8" @ 613 Miss 4441 Miss. ch. 451
 4518' DST 4513-38 open 1 hr gas in
 6 min. rec 1380' free oil 1500#
 TD 4538 5" @ 4519 CO to 4538
 sd-frac. F/136 BO 7 hr.
 F/80 BO 8 hr.
 Schl tops: Heeb 3557' Lans 3753'
 Miss 4439' F/150 BO 8 hr.
 F/392 BO 21 hr. Comp. F/283 BOPD

COMPLETED

