


Section 20 Township 33 Range 11W

Well No. 2 W. A. Newkirk

Company Continental Oil

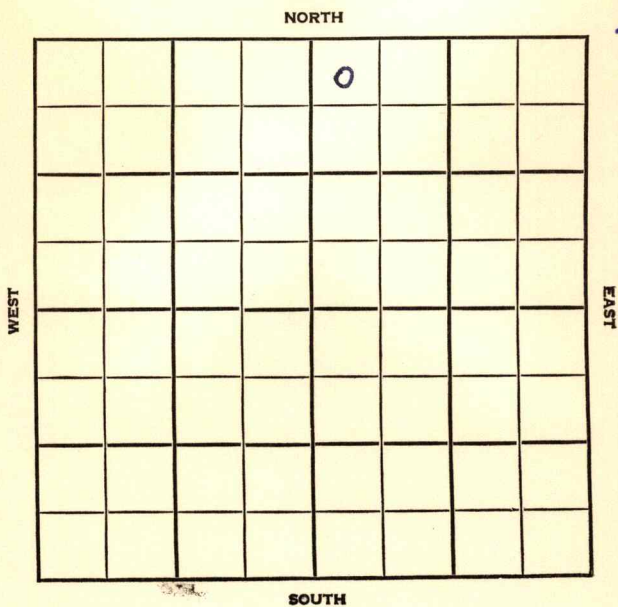

Barber KANSAS


SEC. 20	TWP. 33	R. 11W
------------	------------	-----------

WELL NO. 2 W. A. Newkirk FARM

COMPANY Continental Oil

CONTRACTOR Noble Drlg.
Gerlane Pool

330 Ft. from N. Line
 _____ Ft. from S. Line
 _____ Ft. from E. Line
 330 Ft. from W. Line

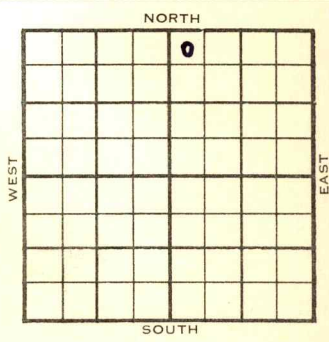

NW NW NE

1954	ELEVATION 1397'	REPORT
------	--------------------	--------

9/8 Spud 9-6-54
 Drlg. 560'

11/10 Spud 9-6-54
 Oil Well
 TD 4500'
 8-5/8" @ 412'
Miss 4430', Miss Ch. 4465'
 DST 4466'-4500' opn 1 hr, rec 140' o &
 gcm 200#
 TD 4500'
 5" @ 4466'
 Schl Tops: **Heeb 3552' Lans 3749'**
Miss 4430'
 CO to 4500' 500 A sd-frac. S/ 4 1/2
 bo F/ 199 bo 20 hr.
 F/ 130 bo 45 bw 24 hr.
 F/ 26 bo 24 hr. F/ 71 bo 24 hr.
 F/ 47 bo 4 hr. sd-oil-frac.
 Comp F/ 451 bopd. 7 bw.

COMPLETED

