


DX 78-1

Section 21 Township 33 Range 11W

Well No. 1 Forester "B"

Company Barbara Oil

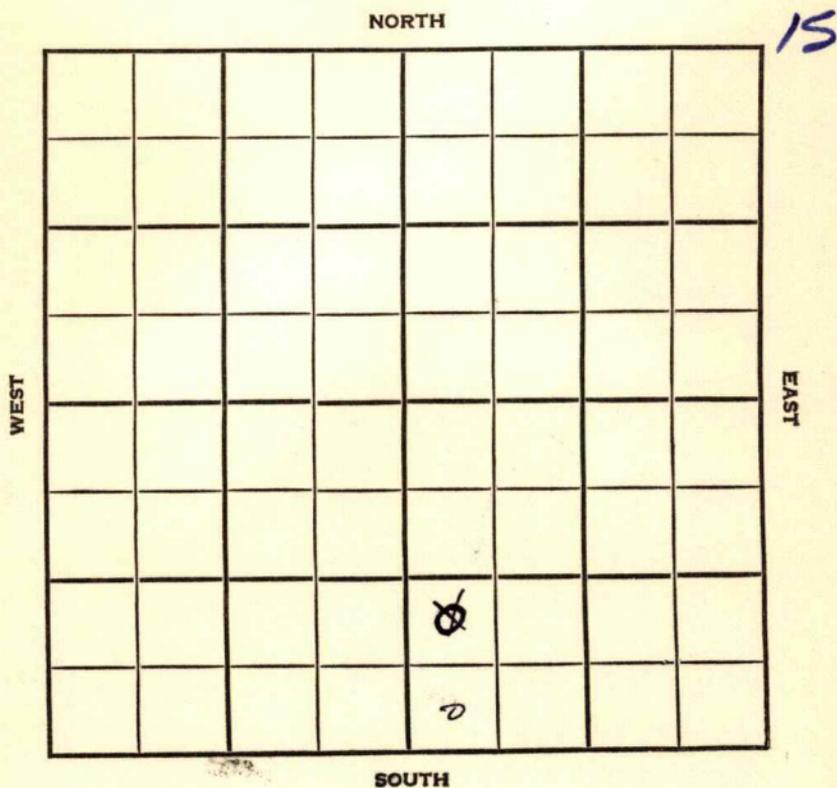


SEC.	TWP.	R.
21	33	11 W

WELL NO. # 1 Forester "B" FARM

COMPANY Barbara Oil

CONTRACTOR Patton  
SE Rhodes Pool

\_\_\_\_\_ Ft. from N. Line  
~~330~~  
~~990~~ \_\_\_\_\_ Ft. from S. Line  
 \_\_\_\_\_ Ft. from E. Line  
 330 \_\_\_\_\_ Ft. from W. Line

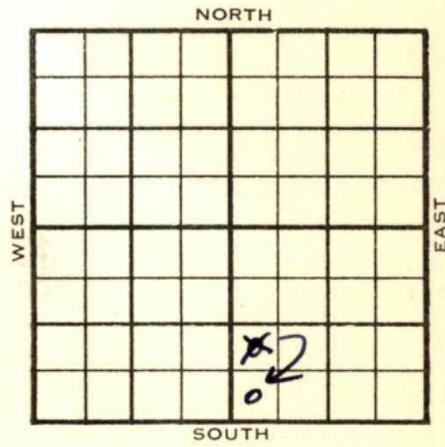

~~NW~~ SW SE

	ELEVATION	REPORT
1954	1412'	

8/4 RJR  
 11/3 Spud 8-9-54 - Oil Well  
 TD 4600'  
 8" @ 230'  
**Anhy 1600', Miss 4503'**  
 TD 4600'  
 5" @ 4600'  
 CO to 4600'  
 1/4594 dry, 11/4586-93,  
 B/5 gw 1 qts. hvy oil  
 12/4560-72, dry  
 4/4555-59, B/30 goph 75% wtr.  
 SP 4547'  
 26/4512-25, dry  
 52/4512-25,  
 B/5 bw SSG  
 B/8-10 go 8-10 gw hydro  
 F/178 bo 24 hrs., 300,000 cfg  
 /156 bo 18 hrs.  
 F/178 bo 24 hrs.  
 F/189 bo 24 hrs.  
 F/4 boph  
 Comp. F/83 bopd

**COMPLETED**

Kansas

Map No. \_\_\_\_\_ Sec. 21 Twp. 33 R. 11W

Well No. 1 Forester "B"

Barbara Oil Company

**CORRECTION** Contractor

SW SW SE


SECTION PLAT

\_\_\_\_\_ Ft. from N. Line

330 Ft. from S. Line

\_\_\_\_\_ Ft. from E. Line

330 Ft. from W. Line

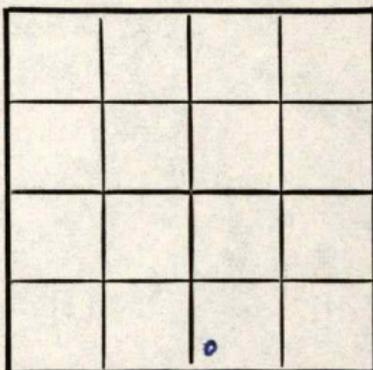

Barber County

Location \_\_\_\_\_

Rig up \_\_\_\_\_

Drilling and Remarks:

Reported

NW SW SE

RECORD

Cased \_\_\_\_\_ in., \_\_\_\_\_ ft.

Sand \_\_\_\_\_

Gas \_\_\_\_\_

Oil \_\_\_\_\_

Total Depth \_\_\_\_\_

PRODUCTION

1st 24 hrs. Nat. \_\_\_\_\_

1st 24 hrs. after shot \_\_\_\_\_

Gas \_\_\_\_\_ Cu. Ft.

Dry Hole \_\_\_\_\_

Abandoned \_\_\_\_\_

Date

4UG 18 1954

19

**FABEN GILSTRAP**

Scout

County Barber State Kansas

Sec. 21 (Blk. Twp.) 33 (Sur. Rge.) 11W Map No.

Operator Barbara Oil

Well No. 1 Farm Forester "B"

Elev. 1412 Location SW SW SE



330 Ft. From S Line SE

330 Ft. From W Line Quarter

1st. Report

Completion NOV 3 1954

Remarks SE Rhodes Pool

Patton - Contr.

Spudding Date 8-9-54

Drlg. Data Oil well TD 4600

8" @ 230 Anhy 1600 Miss. 4503

TD 4600 5" @ 4600 CO to 4600 1/ 4594

dry 14/ 4586-93 B/ 5 gw 1 qt hvy oil

12/ 4560-72 dry 4/ 4555-59 B/ 30 goph

75% wtr. SP 4547 26/ 4512-25 dry

52/ 4512-25 B/ 5 bw SSG B/ 8-10 go

8-10 gw hydro. F/ 178 bo 24 hr.

300,000 cfg F/ 156 bo 18 hr. F/ 178 bo

24 hr. F/ 189 bo 24 hr. F/ 4 boph

Comp. F/ 83 bopd

FABEN GILSTRAP


County **Barber** State **Kansas**

Sec. **21** (Blk. Twp.) **33** (Sur. Rge.) **11W** Map No.

Operator **Barbara Old**

Well No. **1** Farm **Forester "B"**

Elev. Location **NW SW SE**

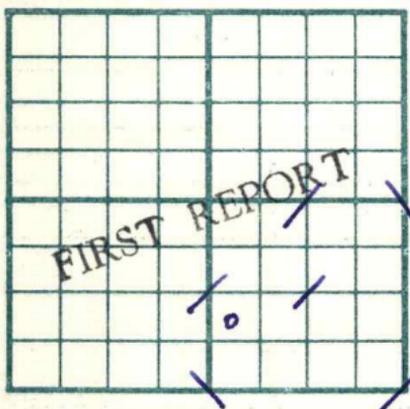

**990** Ft. From **S** Line **SE**

**330** Ft. From **W** Line Quarter

Ist. Report **AUG 4 1954**

Completion

Remarks

**Patton - Contr.**

Spudding Date

Drlg. Data **SE Rhodes Pool**

**RUR**