


Section 20 Township 33 Range 11W

Well No. #6 W.A. Newkirk

Company Continental Oil

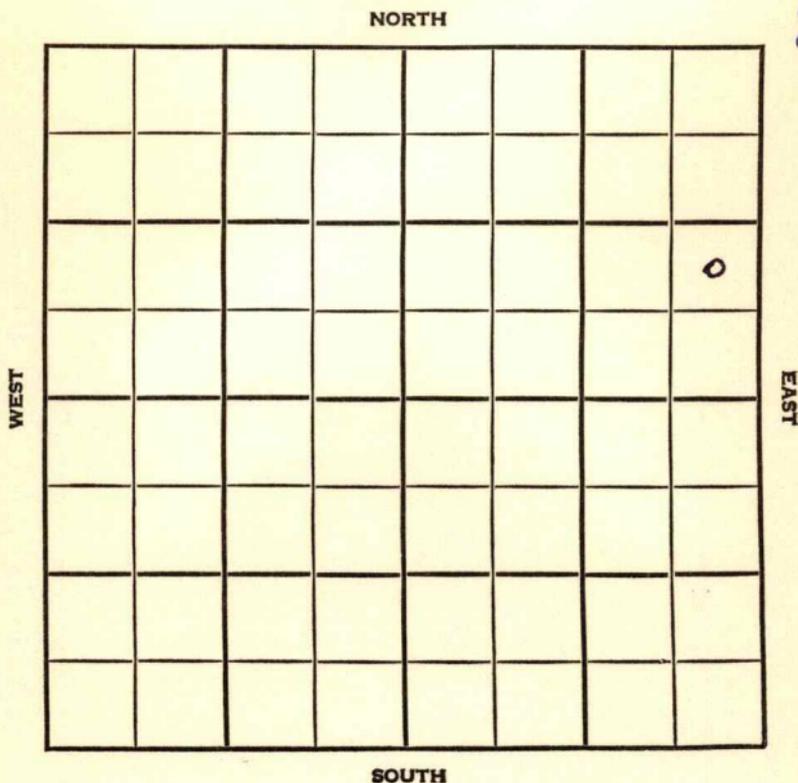

SEC.	TWP.	R.
20	33	11W


WELL NO. #6 W.A. Newkirk FARM

COMPANY Continental Oil

CONTRACTOR Noble Drlg.

Gerlane Pool NORTH

_____ Ft. from N. Line
 990 _____ Ft. from S. Line
 330 _____ Ft. from E. Line
 _____ Ft. from W. Line

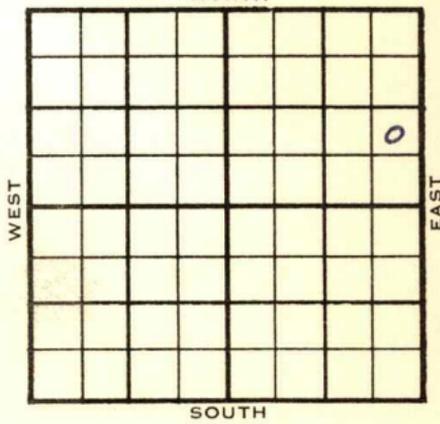

NE SE NE

1954	ELEVATION	REPORT
	1374'	

10/20 Spud 10-14-54
 8" @ 262'
 Drlg. 2650'

11/10 Spud 10-14-54
 Oil Well
 TD 4535'
 8" @ 262'
 Heeb 3685' Lans 3760' Miss 4435'
 TD 4535'
 5" @ 4502'
 CO to 4535'
 sd-frac.
 Comp. F/ 543 bopd.

COMPLETED

